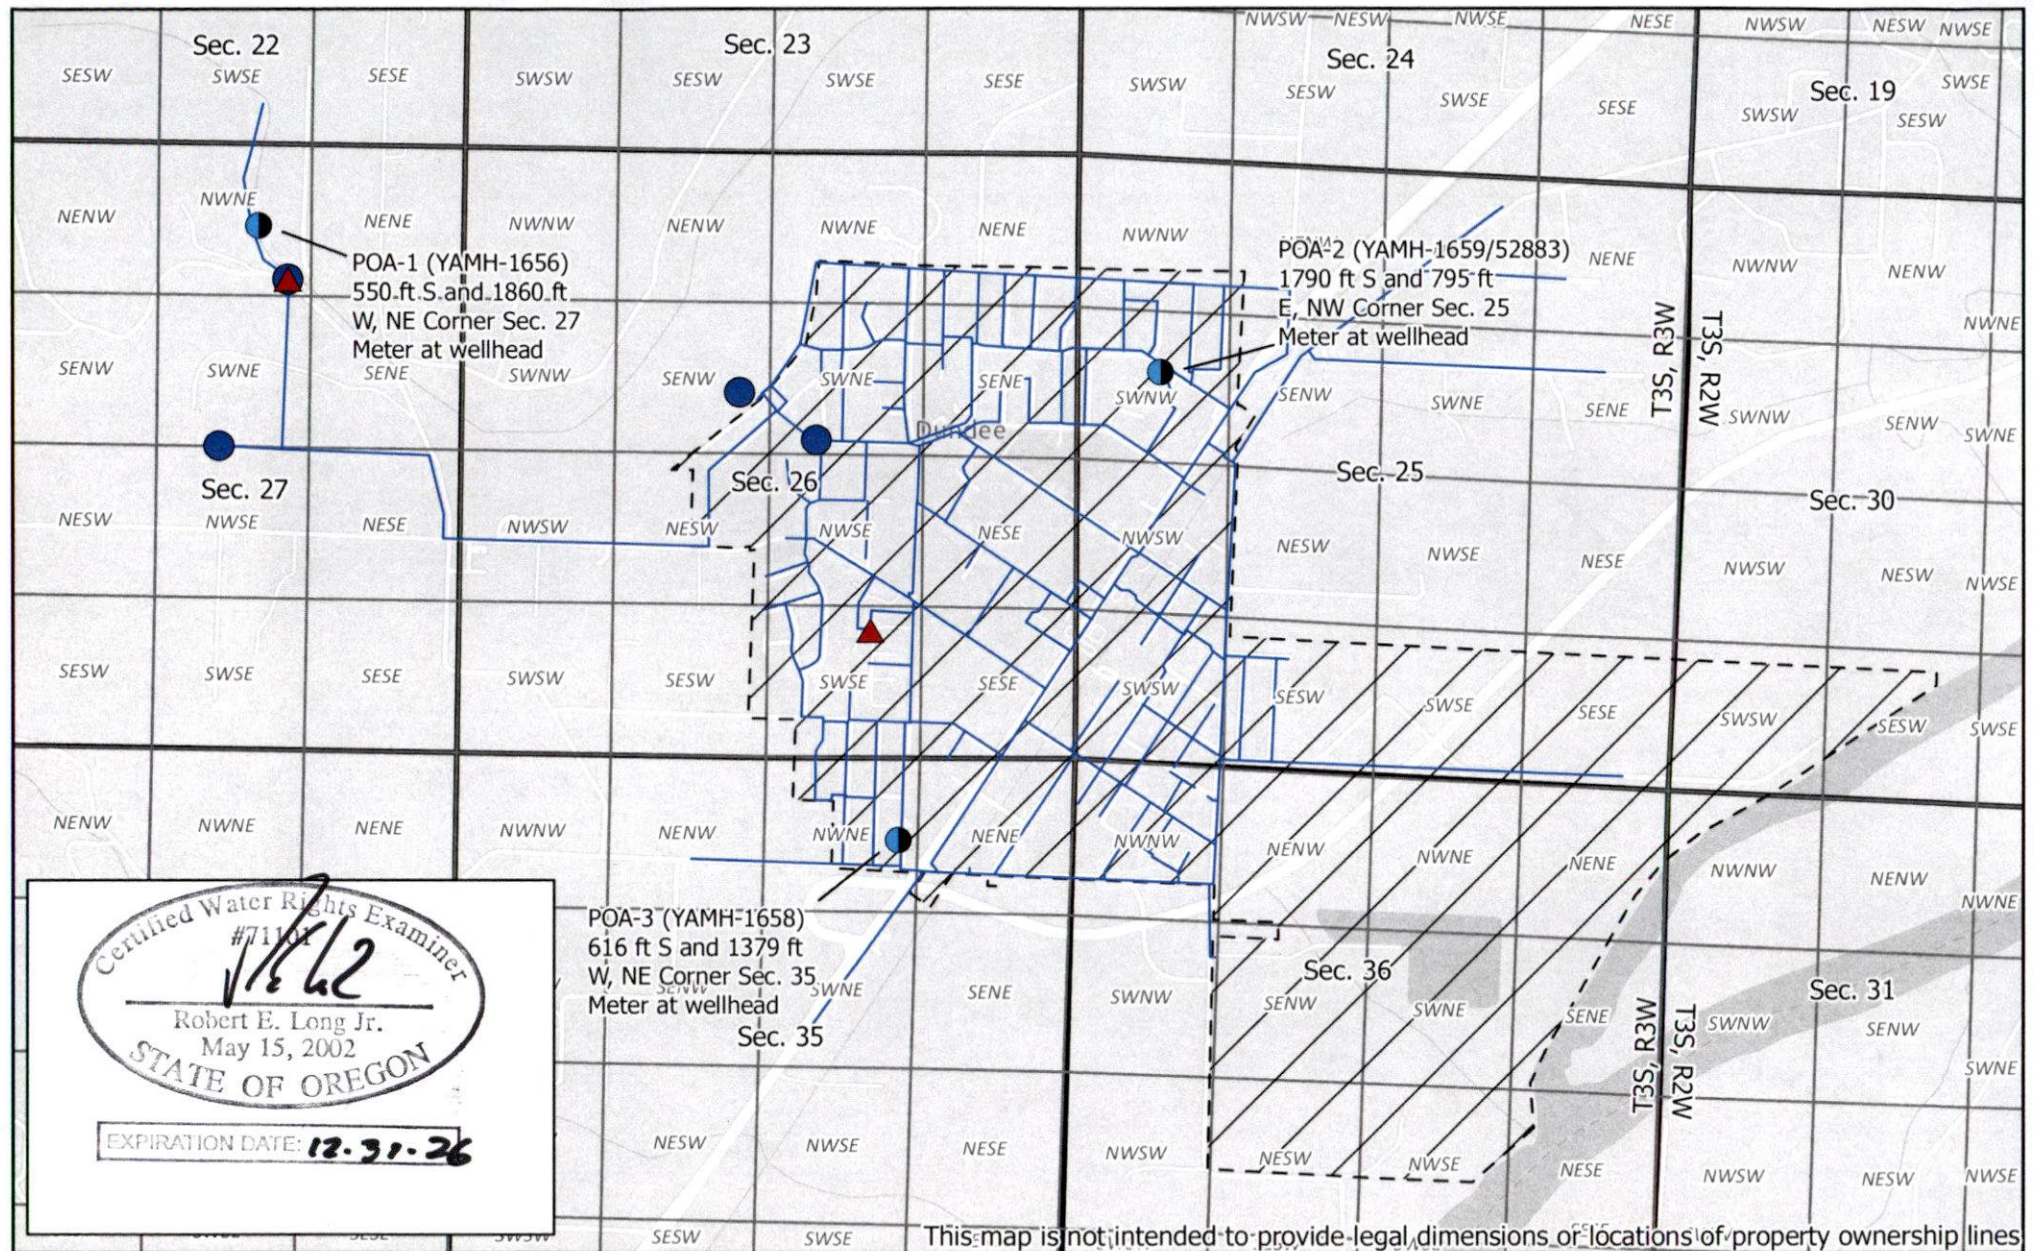


CWM-H2O 
Complete Water Management

311 B Avenue, Suite P
Lake Oswego, Oregon 97034
(503) 954-1326

**Claim of Beneficial Use Map
Permit G-12685
Application G-12568**

1	DATE	AUTH	DRAFT
No.	Date	By	Revisions

N 0 1,000 2,000 Feet
1:20,000

Proj#: 2434001
City of Dundee
City of Dundee
PO Box 220
Dundee, OR 97115

Received
SEP 24 2025
OWRD

-  Dundee UGB (POU)
-  G-12685 POAs
-  Distribution Lines
-  Storage Tanks
-  Pump Stations