




T9S R40E WM

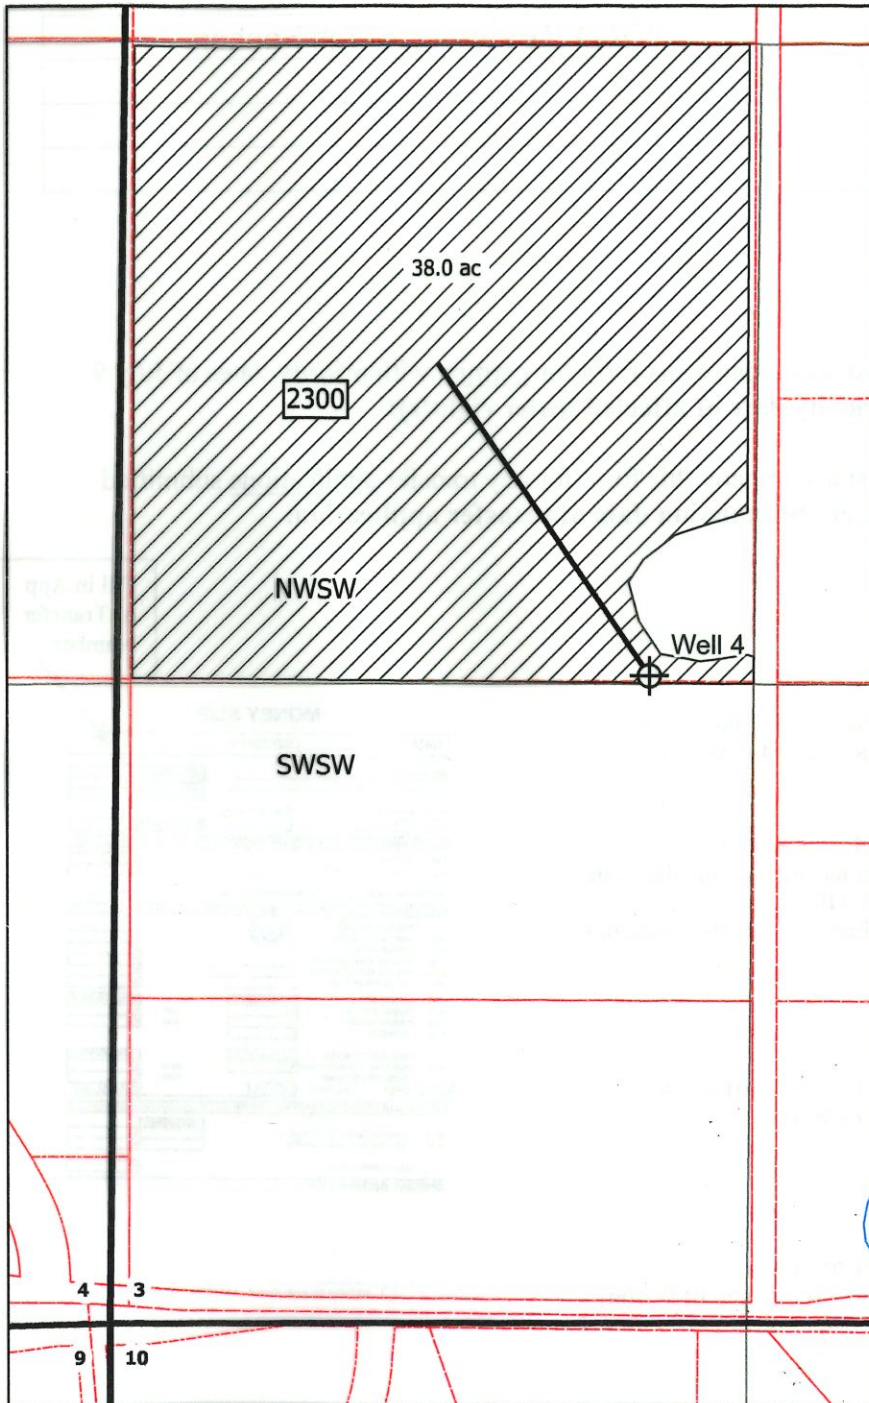

Received
SEP 29 2025
OWRD

LEGEND

-  Place of Use
-  6" Buried Mainline
-  Baker County Taxlot Boundary 2300

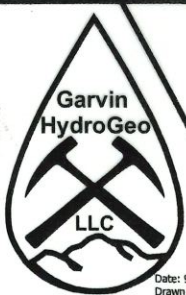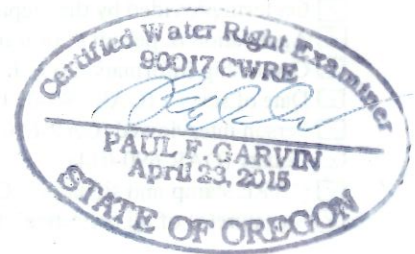

**Claim of Beneficial Use Map
Transfer T-14390
Gyllenberg Property
Baker County, OR**

Prepared on behalf of Christine Gyllenberg

1 inch = 400 feet



Notes:
Well 4: 1,348' N and 1,130' E from the SE Corner of Section 4

Flometer locate 4 ft W of Well 4

This map is not intended to provide legal dimensions or locations of property ownership lines.