


T.4S. R.3W. Section 31 and T.5S. R.3W. Section 6, W.M.

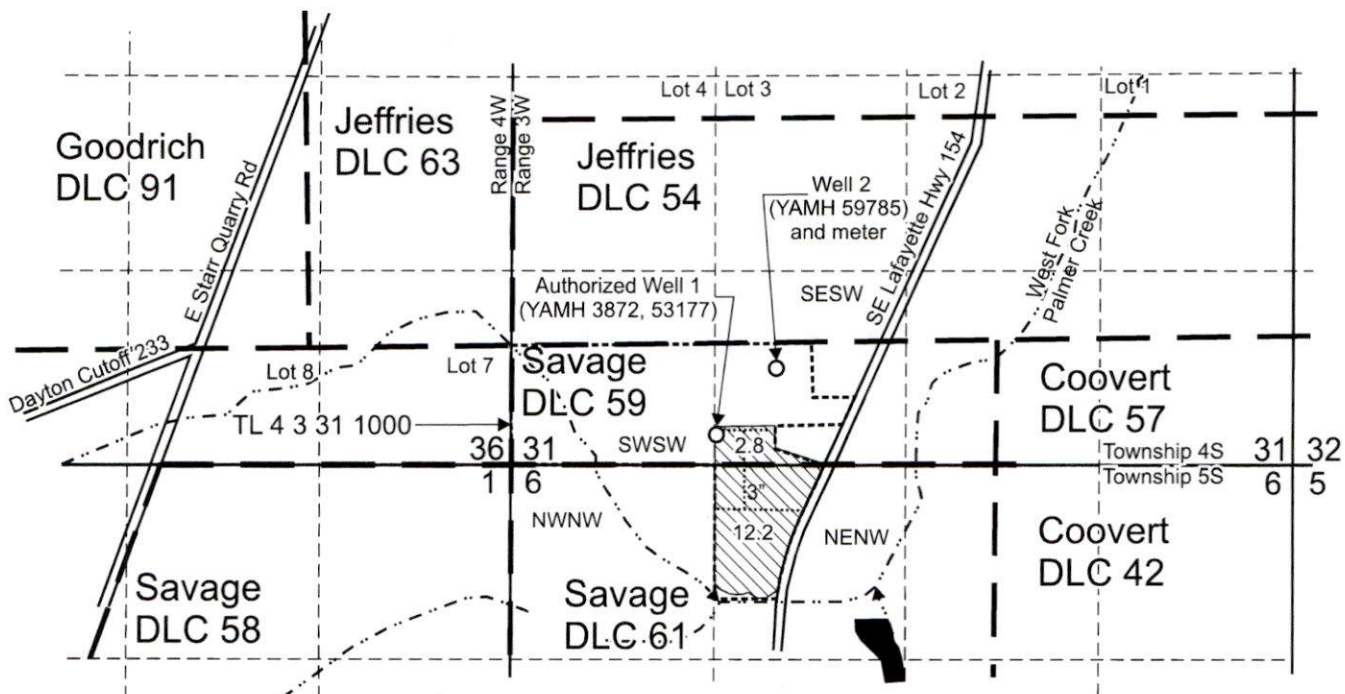

Well 1 (YAMH 3872, 53177) is located 200 feet north and 1,410 feet east from the SW corner, Section 31.

Well 2 (YAMH 59785) is located 655 feet north and 1,830 feet east from the SW corner, Section 31.

 Area (15.0 Acres) irrigated under T-14293, formerly Certificate 80155 priority date: 11-28-1994.

----- Tax lot boundary

— • — Donation Land Claim boundary

..... Irrigation mainlines

Received
OCT 06 2025
OWRD



Scale: 1" = 1,320'



0 1,320
Feet

This map was prepared for the purpose of identifying the location of a water right only and is not intended to provide legal dimensions or location of property ownership lines.

Claim of Beneficial Use Map
T-14293, formerly Certificate 80155

Pacific Hydro-Geology Inc.

10/2025

Kit Johnston
T.4S. R.3W. Section 31
T.5S. R.3W. Section 6, W.M.