

NESW

CAPITAL CITY
NWSE

EAST
FRUIT
NESE

FARMS



Scale 1"=400'

Legend



-  Irrigated area
-  Tax lot boundary
-  Mainline

Notes:

Pump and meter located at POA

THIS MAP IS NOT INTENDED TO PROVIDE LEGAL DIMENSIONS OR LOCATIONS OF PROPERTY OWNERSHIP LINES.

BK Water Right Consulting
PO Box 13434, Salem, OR 97301
503.910.9212

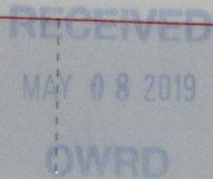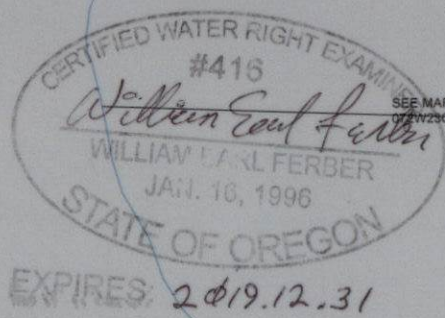

07 2W 22D

SEE MAP 072W27B

SEE MAP 072W27

SEE MAP 072W23C

CR 747

69TH AVE

Gerig Well

0.1

FRUIT
SWSE

SESE

024 00 21 0

004 00 21 0

CONIFER ST NE

CONIFER

STREET NE

1/4 COR

1/4 COR

FRUITLAND RD

1170'

1200'

250'

24

25

