


Claim of Beneficial Use - Meyer
Application G-18355, Permit G-17892

Township 12S, Range 4W, W.M.

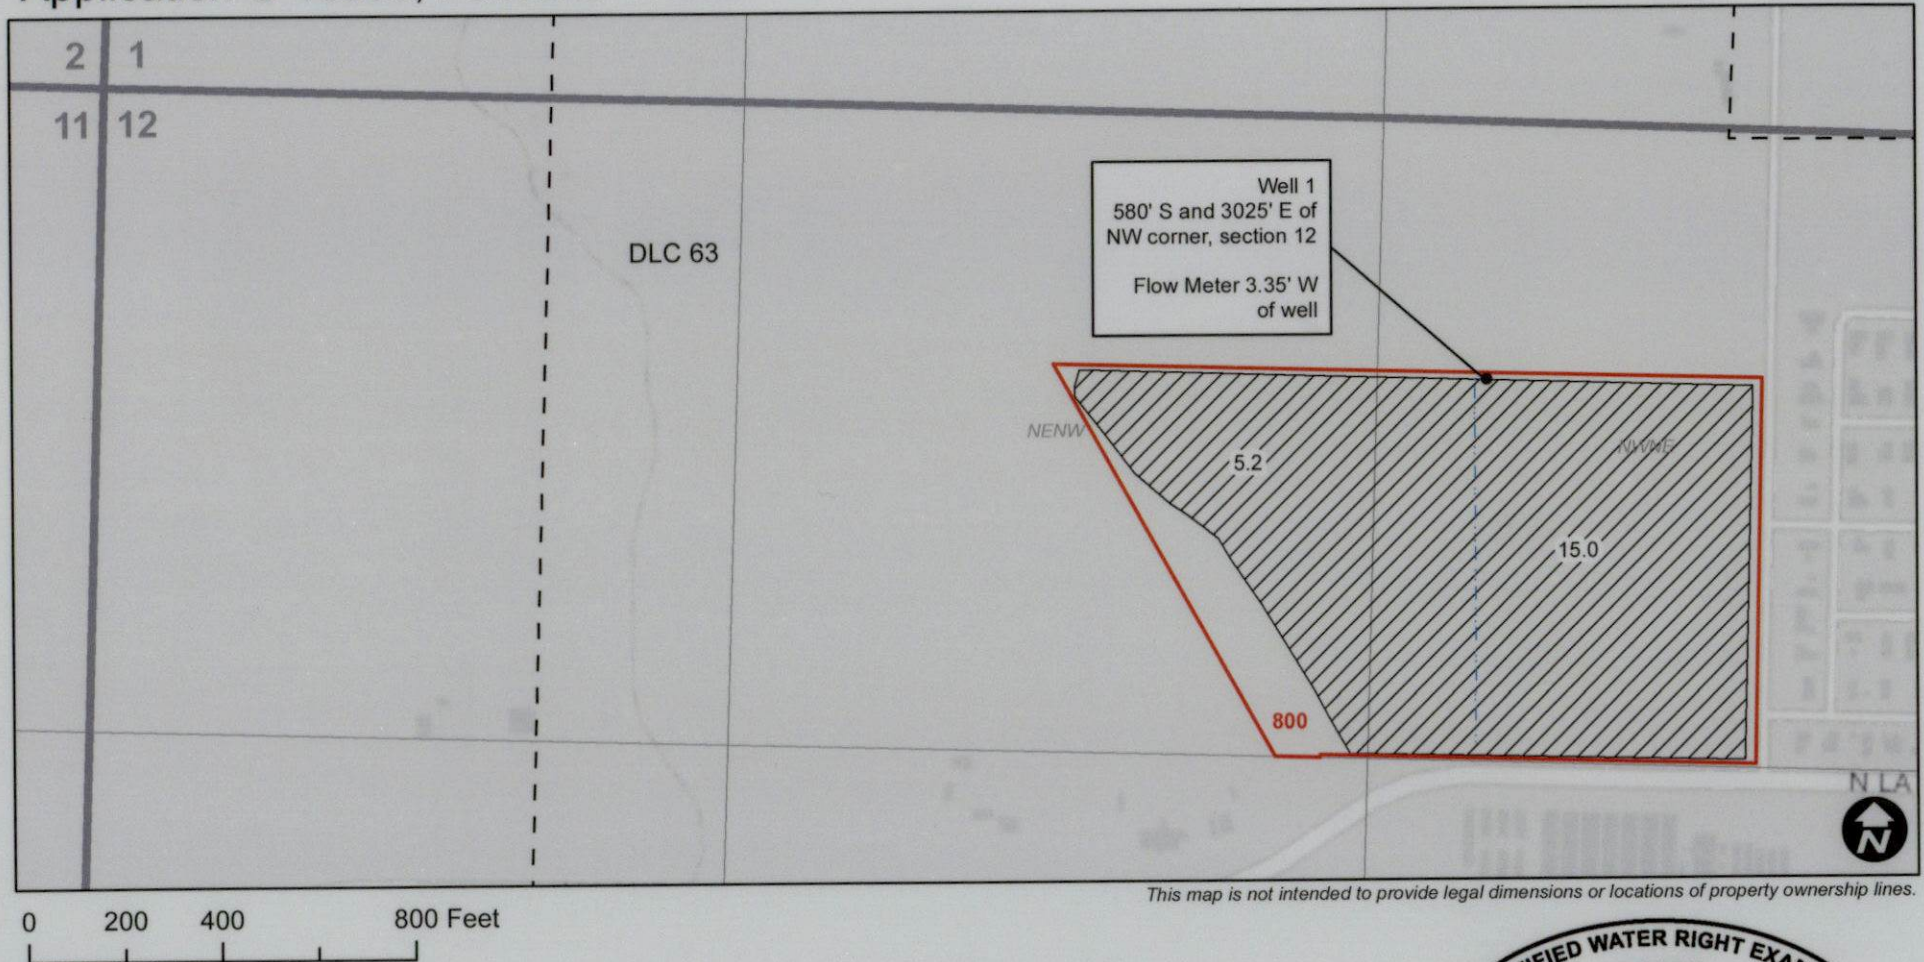

Legend

IR POU Mainline DLC Taxlot

Received by OWRD
OCT 10 2025
Salem, OR

