


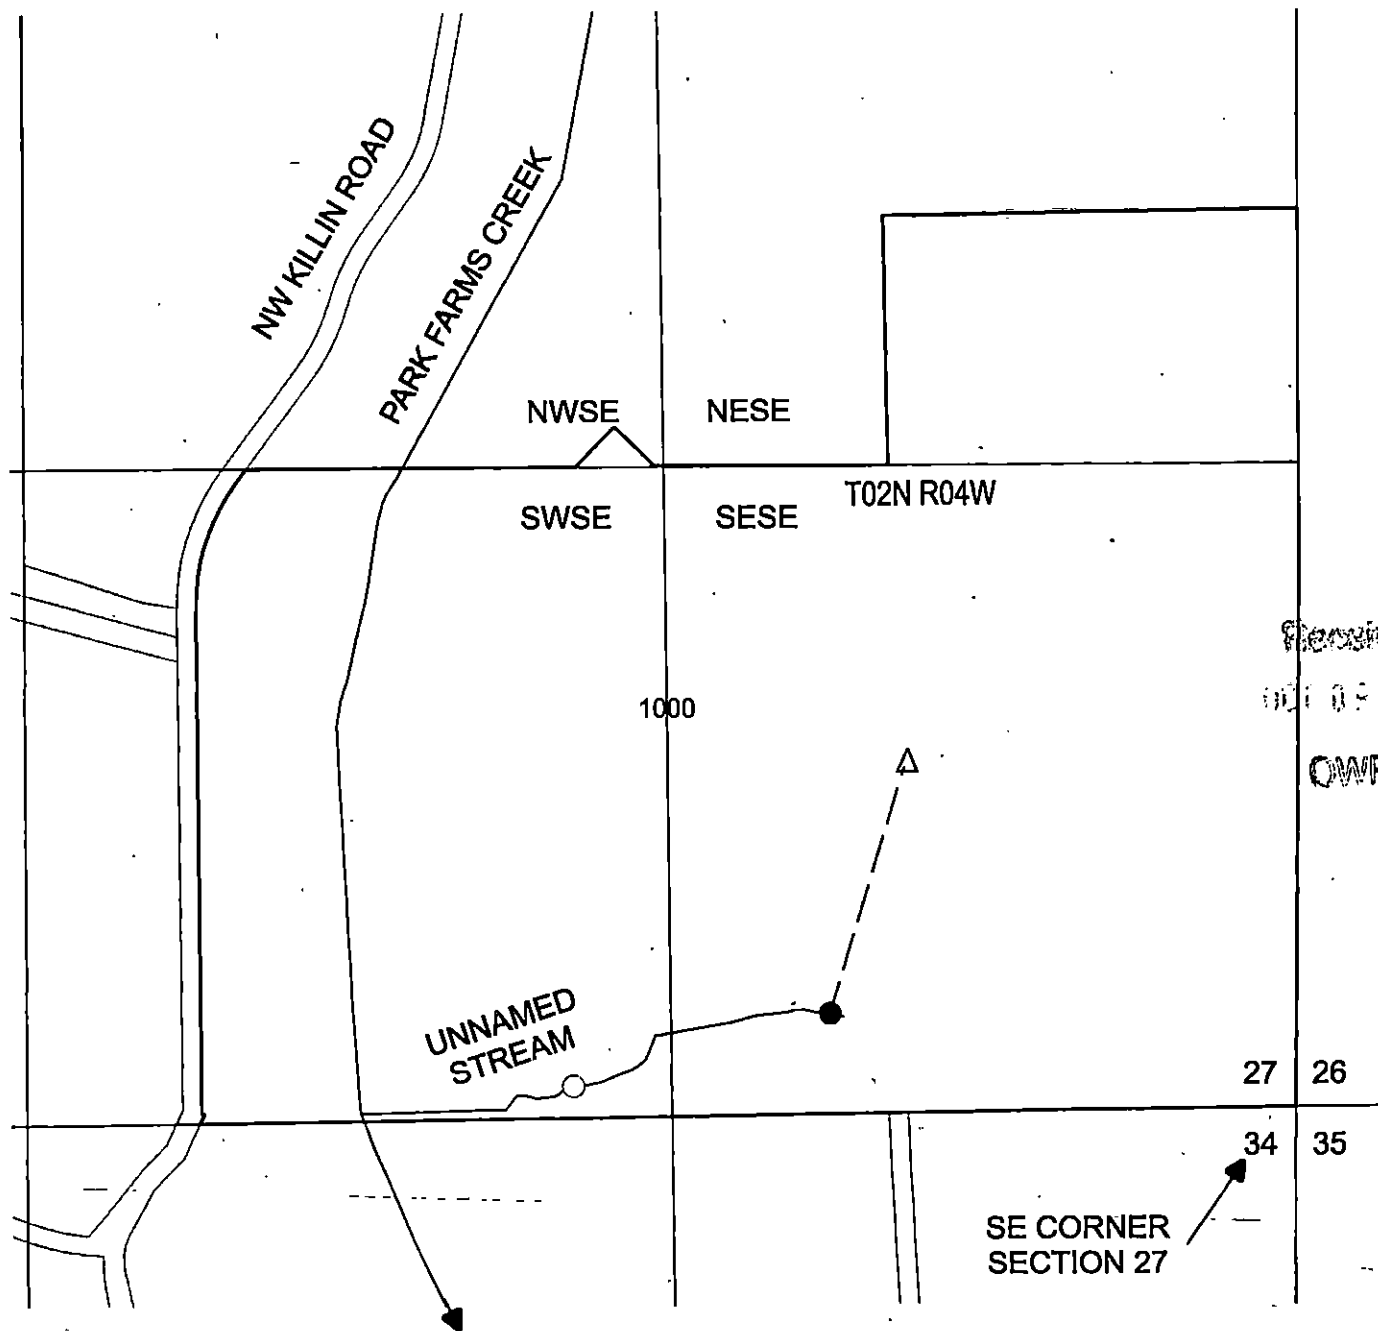

RICK AND ALISON LARSON
46780 NW GRAHAM RD
BANKS, OR 97106

TRANSFER 13358
CERTIFICATE 29781

SITUATED IN
SECTION 27, TOWNSHIP 2N
RANGE 4W, W.M.

WASHINGTON COUNTY
OREGON

LEGEND

- LARSON DIVERSION
60' NORTH 1500' WEST
FROM SE CORNER
SECTION 27
- LARSON APOD & METER
200' NORTH 960' WEST
FROM SE CORNER
SECTION 27
- COMMERCIAL POU
TAX LOT 1000
- △ TANKS / FILLING STATION
- PIPELINES



0

400 ft

This map is not intended to provide
legal dimensions or locations of
property ownership lines

ParsonsWater Consulting LLC
rick.parsons@parsonwater.com
541.499.0257 303.667.5067

