CLAIM OF BENEFICIAL USE MAP

TO ADD PLACE OF USE FOR STORAGE
PER APPLICATION R-39435
OREGON DEPARTMENT OF STATE LANDS

NE 1/4 SECTION 23, TOWNSHIP 36 SOUTH, RANGE 48 EAST, W.M.
TAX LOT: 501, MALHEUR COUNTY, OREGON

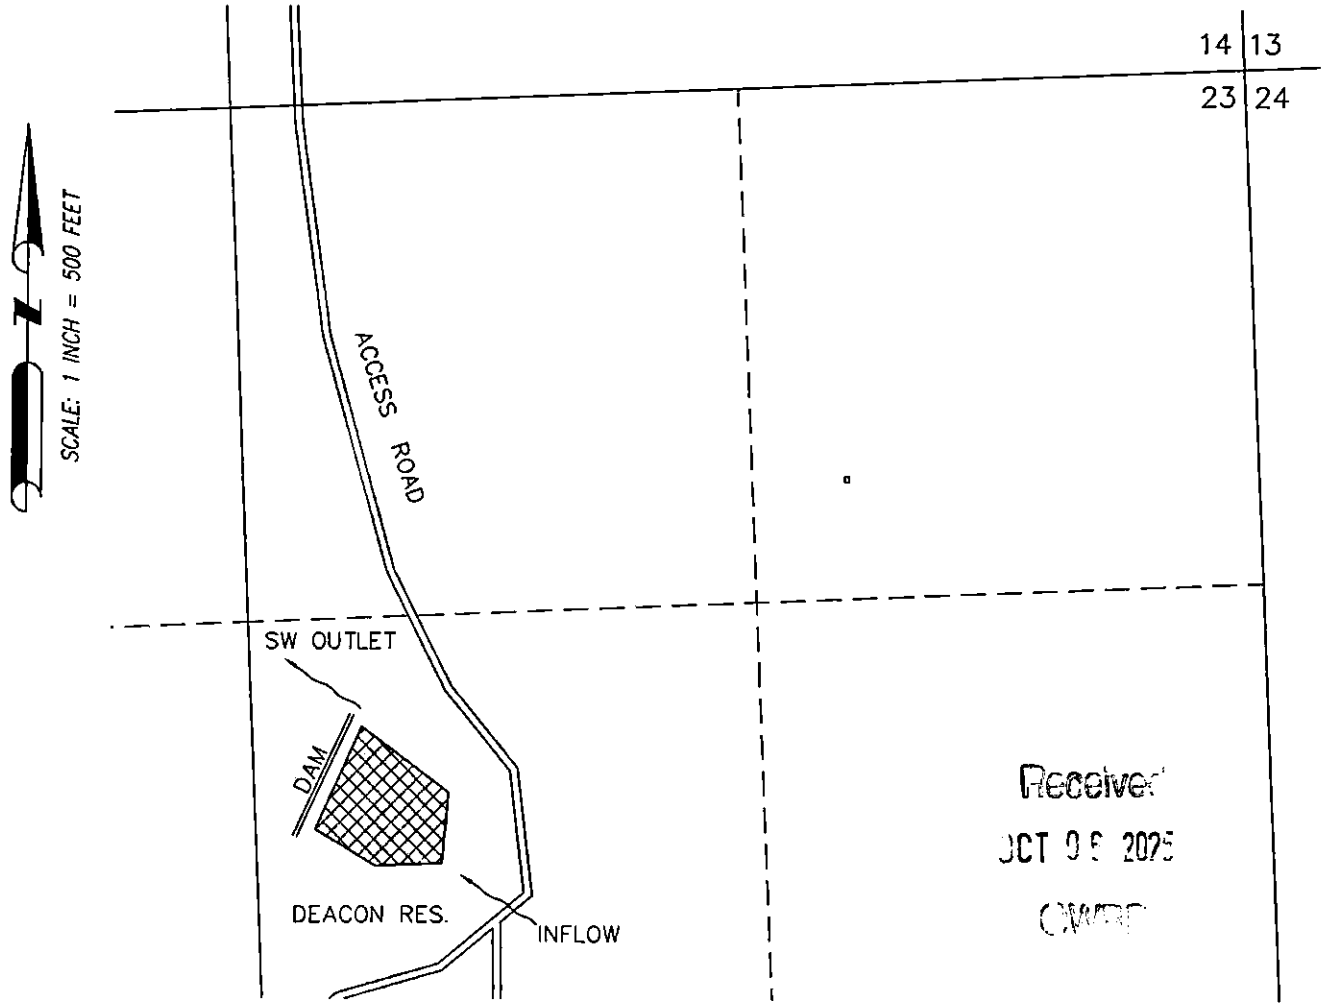

Certified Water Right Examiner
#51324 WRE
Scott D. Montgomery
May 21, 2001
STATE OF OREGON

RENEWAL DATE: 12/31/2026

ROSS #1

2.53 ACRE-FEET STO WITHIN SW 1/4 NE 1/4 SECTION 23 FROM SEASONAL RUNOFF, AS SHOWN.

POD AT CENTER OF DAM IS LOCATED 1730' S & 180' E FROM 1/4 CORNER COMMON TO SECTIONS 14 & 23.

THIS MAP IS FOR THE PURPOSE OF LOCATING A WATER RIGHT ONLY AND HAS NO INTENT TO PROVIDE LEGAL DIMENSIONS OR THE LOCATION OF PROPERTY LINES.

PREPARED FOR:	PREPARED BY:
OREGON DEPARTMENT OF STATE LANDS 775 SUMMER STREET NE #100 SALEM, OR 97301	ALL POINTS ENGINEERING AND SURVEYING, INC. P.O. BOX 767 TERREBONNE, OR 97760 (541) 548-5833 www.APEandS.com