



CLAIM OF BENEFICIAL USE MAP

TO ADD PLACE OF USE FOR STORAGE"
PER APPLICATION R-67880
OREGON DEPARTMENT OF STATE LANDS

SE 1/4 SECTION 1, TOWNSHIP 29 SOUTH, RANGE 37 EAST, W.M.
TAX LOT: 101, MALHEUR COUNTY, OREGON

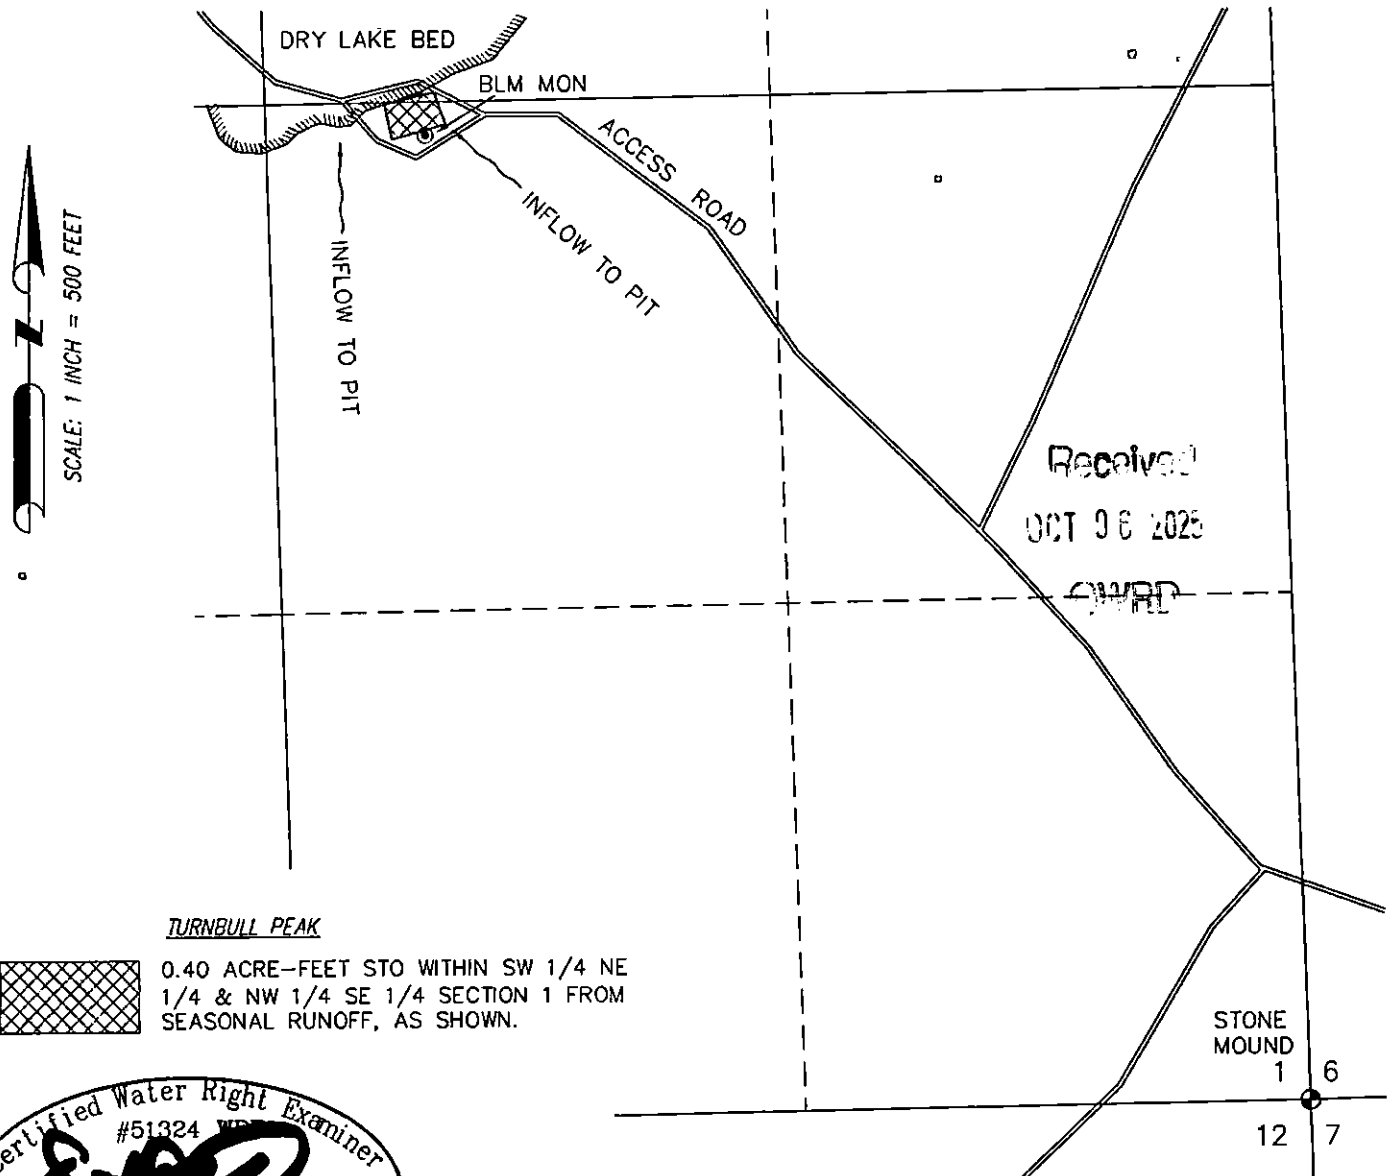

0.40 ACRE-FEET STO WITHIN SW 1/4 NE
1/4 & NW 1/4 SE 1/4 SECTION 1 FROM
SEASONAL RUNOFF, AS SHOWN.

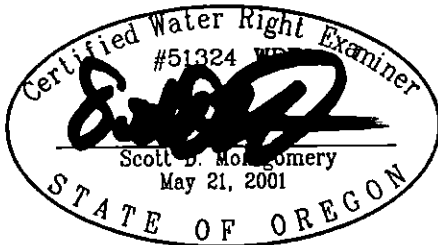

RENEWAL DATE: 12/31/2026

POD AT CENTER OF PIT IS LOCATED 2590'
N & 2240' W FROM SE CORNER SECTION 1.

THIS MAP IS FOR THE PURPOSE OF LOCATING A WATER RIGHT ONLY AND HAS NO
INTENT TO PROVIDE LEGAL DIMENSIONS OR THE LOCATION OF PROPERTY LINES.

PREPARED FOR:

OREGON DEPARTMENT OF STATE LANDS
775 SUMMER STREET NE #100
SALEM, OR 97301

PREPARED BY:



ALL POINTS ENGINEERING AND SURVEYING, INC.
P.O. BOX 767 TERREBONNE, OR 97760
(541) 548-5833
www.APEandS.com