


CLAIM OF BENEFICIAL USE MAP

TO ADD PLACE OF USE FOR STORAGE
PER APPLICATION R-67882
OREGON DEPARTMENT OF STATE LANDS

NW 1/4 SECTION 13, TOWNSHIP 29 SOUTH, RANGE 37 EAST, W.M.
TAX LOT: 101, MALHEUR COUNTY, OREGON

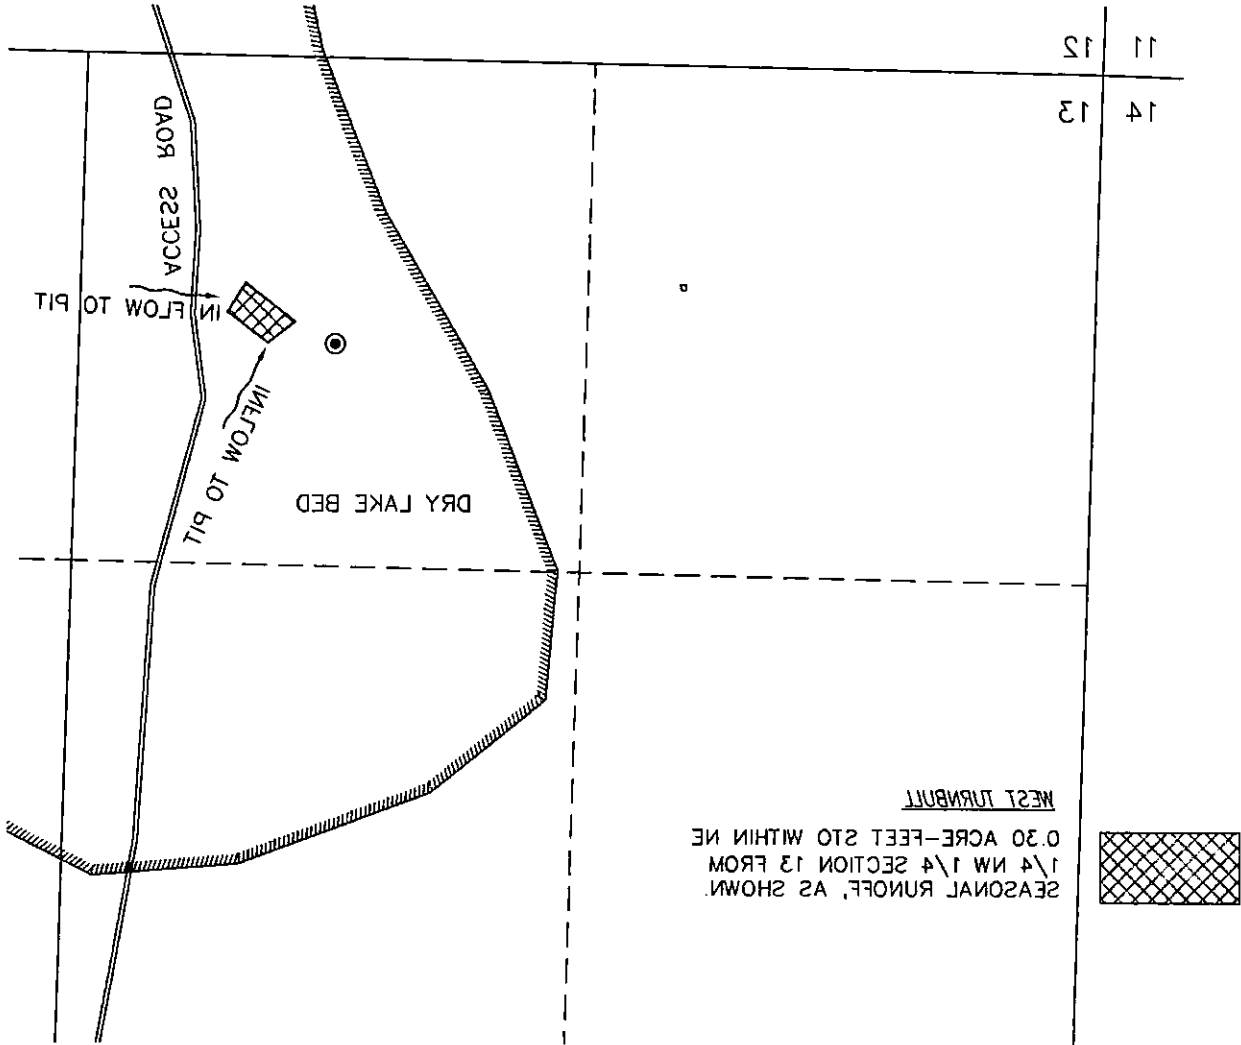

WEST TURNBULL
0.30 ACRE- FEET 210 WITHIN NE
1/4 NW 1/4 SECTION 13 FROM
SEASONAL RUNOFF, AS SHOWN




POB AT CENTER OF PIT IS LOCATED 675.2
& 490. W FROM 1/4 CORNER COMMON TO
SECTIONS 12 & 13.

Received
OCT 06 2025

OWRD

THIS MAP IS FOR THE PURPOSE OF LOCATING A WATER RIGHT ONLY AND HAS NO
INTENT TO PROVIDE LEGAL DIMENSIONS OR THE LOCATION OF PROPERTY LINES.



RENEWAL DATE: 12/31/2026

PREPARED FOR:

OREGON DEPARTMENT OF STATE LANDS
725 SUMMER STREET NE #100
SALEM, OR 97301

PREPARED BY:



(541) 548-5833
P.O. BOX 767 TERREBONNE, OR 97760
ALL POINTS ENGINEERING AND SURVEYING, INC.
www.APEandS.com



CLAIM OF BENEFICIAL USE MAP


TO ADD PLACE OF USE FOR STORAGE
PER APPLICATION R-67882
OREGON DEPARTMENT OF STATE LANDS

NW 1/4 SECTION 13, TOWNSHIP 29 SOUTH, RANGE 37 EAST, W.M.
TAX LOT: 101, MALHEUR COUNTY, OREGON

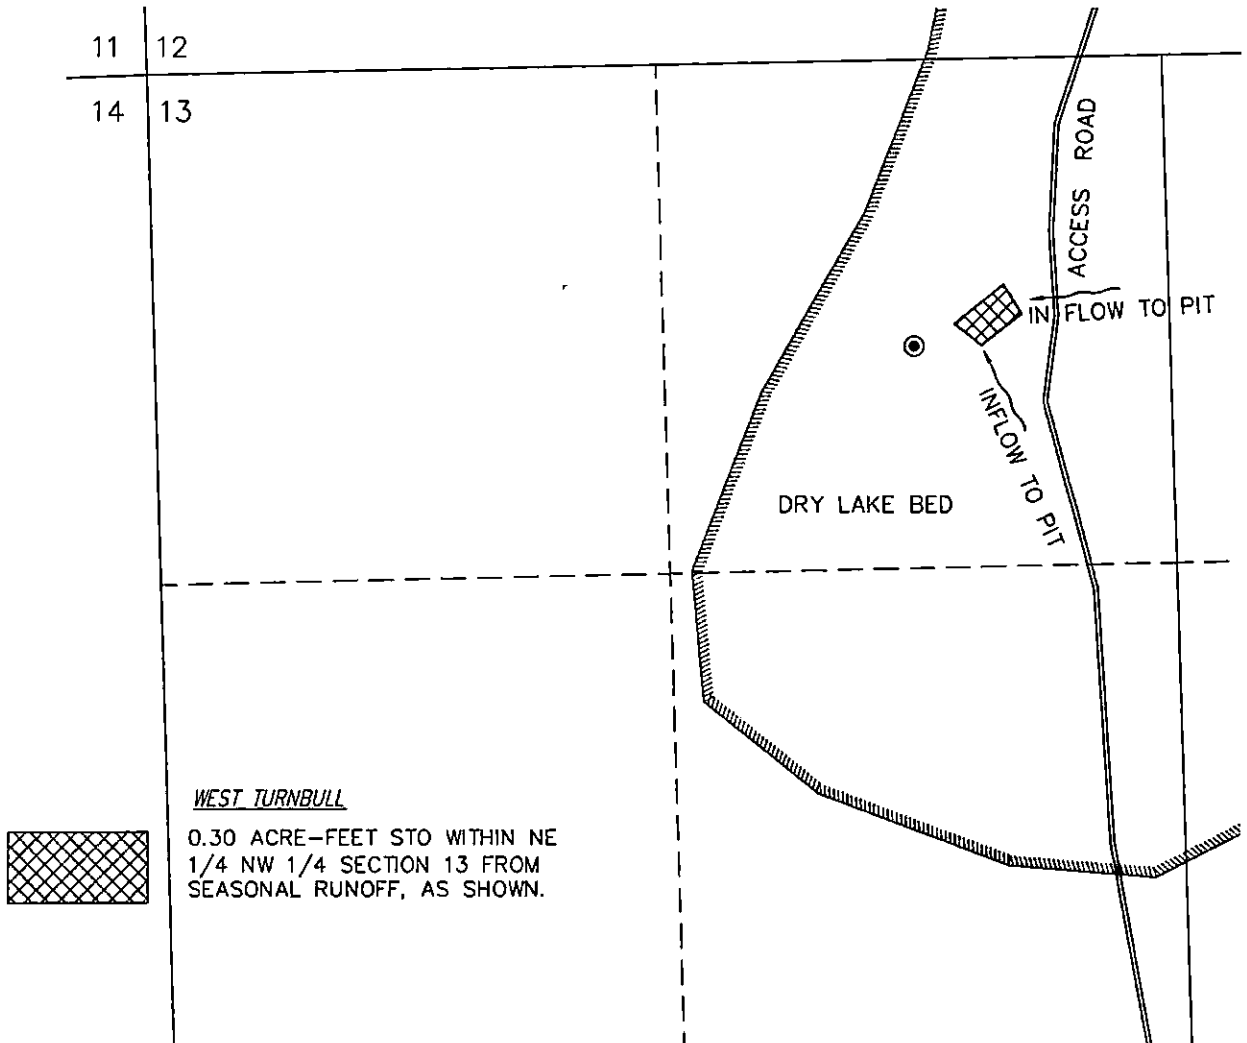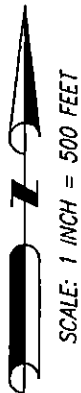

WEST TURNBULL

0.30 ACRE-FEET STO WITHIN NE
1/4 NW 1/4 SECTION 13 FROM
SEASONAL RUNOFF, AS SHOWN.

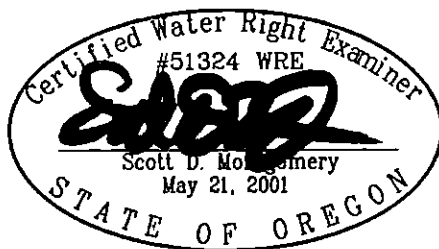

RENEWAL DATE: 12/31/2026

Received

OCT 06 2025

CWRD

POD AT CENTER OF PIT IS LOCATED 675' S
& 490' W FROM 1/4 CORNER COMMON TO
SECTIONS 12 & 13.

THIS MAP IS FOR THE PURPOSE OF LOCATING A WATER RIGHT ONLY AND HAS NO
INTENT TO PROVIDE LEGAL DIMENSIONS OR THE LOCATION OF PROPERTY LINES.

PREPARED FOR:

OREGON DEPARTMENT OF STATE LANDS
775 SUMMER STREET NE #100
SALEM, OR 97301

PREPARED BY:



ALL POINTS ENGINEERING AND SURVEYING, INC.
P.O. BOX 767 TERREBONNE, OR 97760
(541) 548-5833
www.APEandS.com