



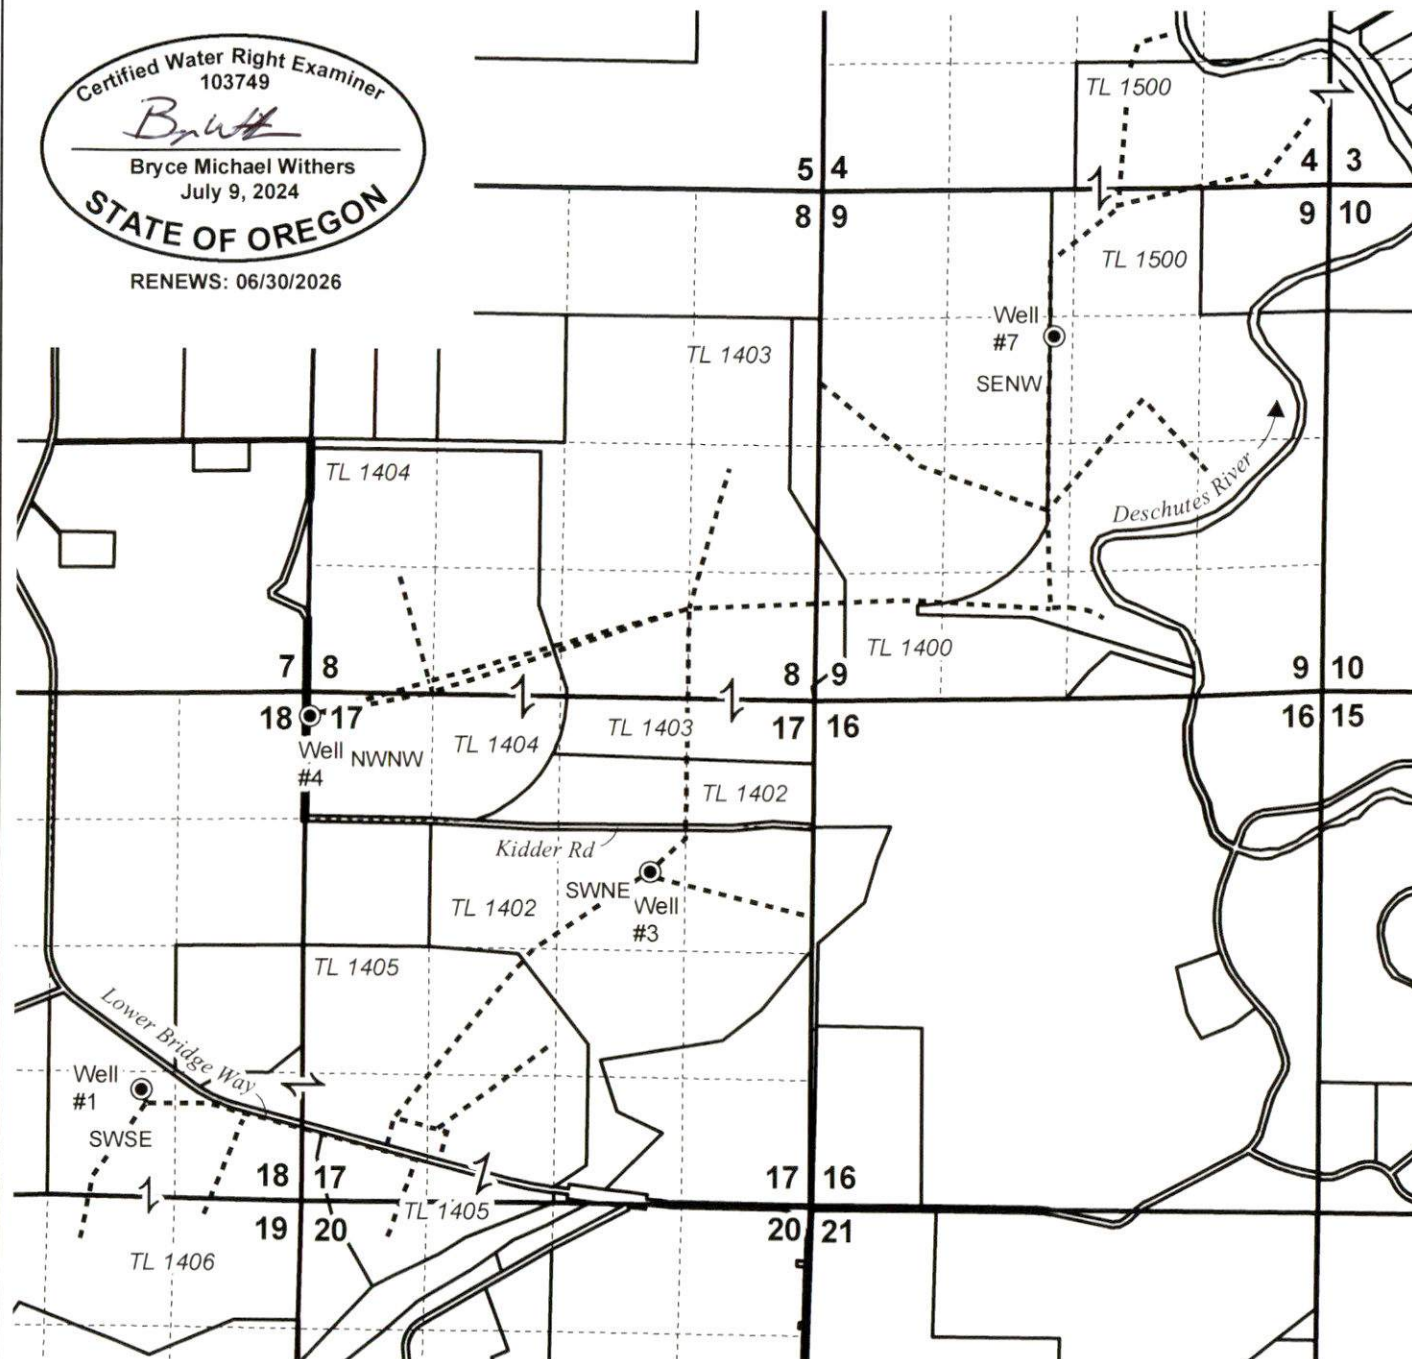

T14S R12E, WM DESCHUTES COUNTY, OR

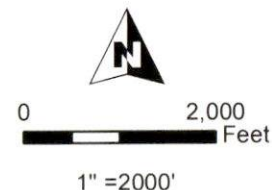

- Well
- Pipeline
- Section
- Quarter Quarter
- Tax Lot

Received
OCT 10 2025
OWRD

Well Locations:

Well #1 (DESC 2100):
1154.2' N, 1680.6' W of SE Cor Sec 18

Well #3 (DESC 2087/L-122702):
1772.1' S, 1706.6' W of NE Cor Sec 17

Well #4 (DESC 2098/L-122703):
240.7' S, 32.2' E of NW Cor Sec 17

Well #7 (DESC 768/L-122706):
1571.4' S, 2862.6' W of NE Cor Sec 9



CLAIM OF BENEFICIAL USE MAP Big Falls Ranch

Date: 7/3/2025


Well & Delivery System Map

T-14066

This map is not intended
to provide legal dimensions
or locations of property
ownership lines.

WATER RIGHT SERVICES, LLC
PO BOX 1830, BEND, OR 97709
WWW.OREGONWATER.US CCB # 197121
johnshort@usa.com 541-389-2837


T14S R12E, WM DESCHUTES COUNTY, OR

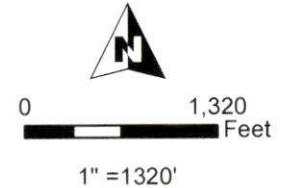

- Well
- POU (IS) 4/13/1967 Priority
- Section
- Quarter Quarter
- Tax Lot

Received
OCT 10 2025

OWRD

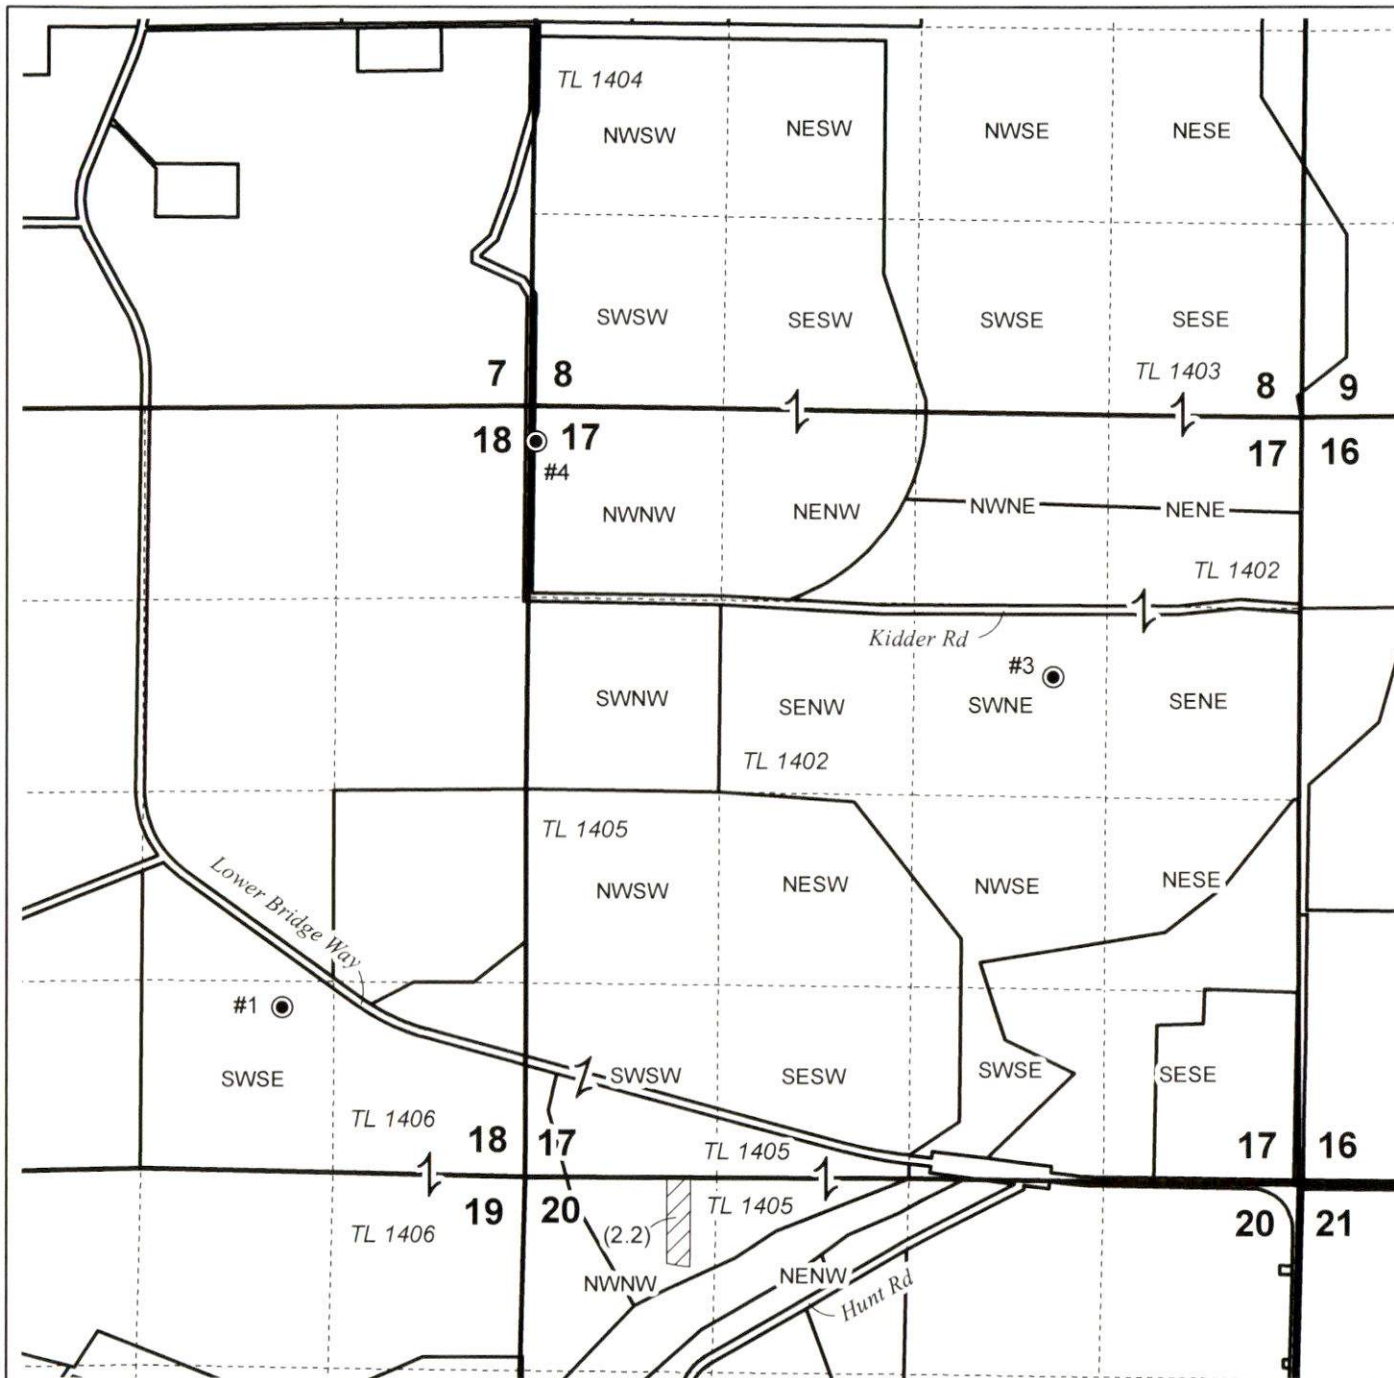

CLAIM OF BENEFICIAL USE MAP Big Falls Ranch

Date: 7/3/2025


4/13/1967 Priority (perfected under Permit S-32049)

T-14066

This map is not intended
to provide legal dimensions
or locations of property
ownership lines.

WATER RIGHT SERVICES, LLC
PO BOX 1830, BEND, OR 97709
WWW.OREGONWATER.US CCB # 197121
johnshort@usa.com 541-389-2837


T14S R12E, WM DESCHUTES COUNTY, OR

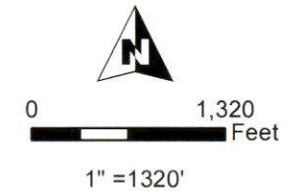

- Well
- POU (IS) 10/23/1973 Priority
- Section
- Quarter Quarter
- Tax Lot

Received
OCT 10 2025

OWRD

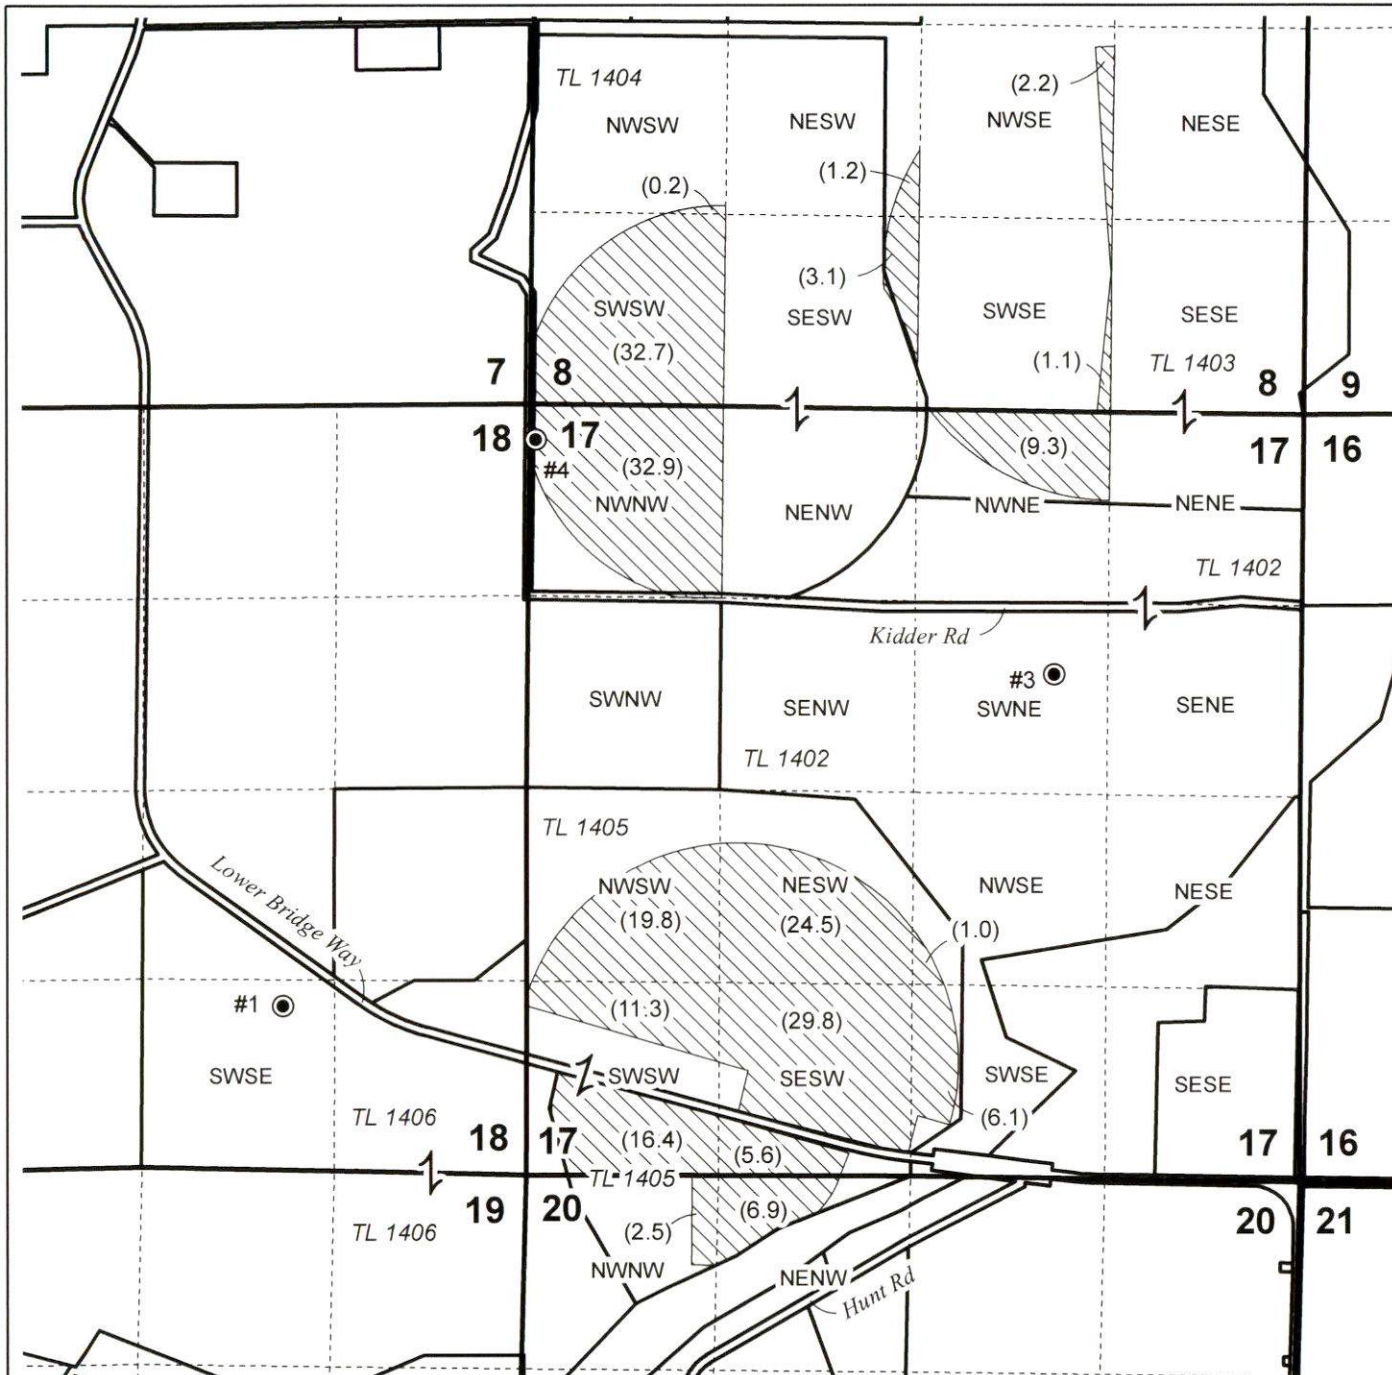

CLAIM OF BENEFICIAL USE MAP Big Falls Ranch

Date: 7/3/2025

10/23/1973 Priority (perfected under Permit S-37392)

T-14066

This map is not intended
to provide legal dimensions
or locations of property
ownership lines.

WATER RIGHT SERVICES, LLC
PO BOX 1830, BEND, OR 97709
WWW.OREGONWATER.US CCB # 197121
johnshort@usa.com 541-389-2837