

LEGEND

- POD 2, POINT OF RE-DIVERSION
FISH SCREEN & FLOW METER
790' SOUTH AND 350' WEST
FROM E4 CORNER, SECTION 16
- PLACE OF USE
QUASI-MUNICIPAL
- WATER MAIN
- QUARTER-QUARTER
- GOVERNMENT LOTS


CLAIM OF BENEFICIAL USE MAP

APPLICATION: S-86478
PERMIT: S-54348
PRIORITY DATE: JANUARY 10, 2006

QUASI-MUNICIPAL USE

FOR
SUNSTONE WATER, LLC
250 SW TAYLOR STREET
PORTLAND, OR 97204


SITUATED IN
SECTIONS 9, 10, 15, 16, 21, TOWNSHIP 34 SOUTH, RANGE 1 WEST, W.M.
JACKSON COUNTY, OREGON

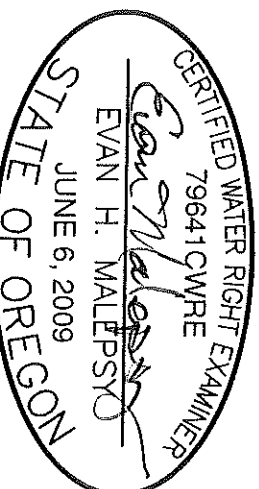



RENEWS: 12/31/2026

EHM-September 15, 2025
ROGUE CIVIL LLC
emalepsy@roguecivil.com 541-621-2868

0 660 1320
SCALE: 1"=1320'

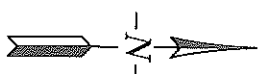

LOST CREEK RESERVOIR
POINT OF DIVERSION
T.33S.,R.1E.,W.M.
SCALE: 1"=1320'

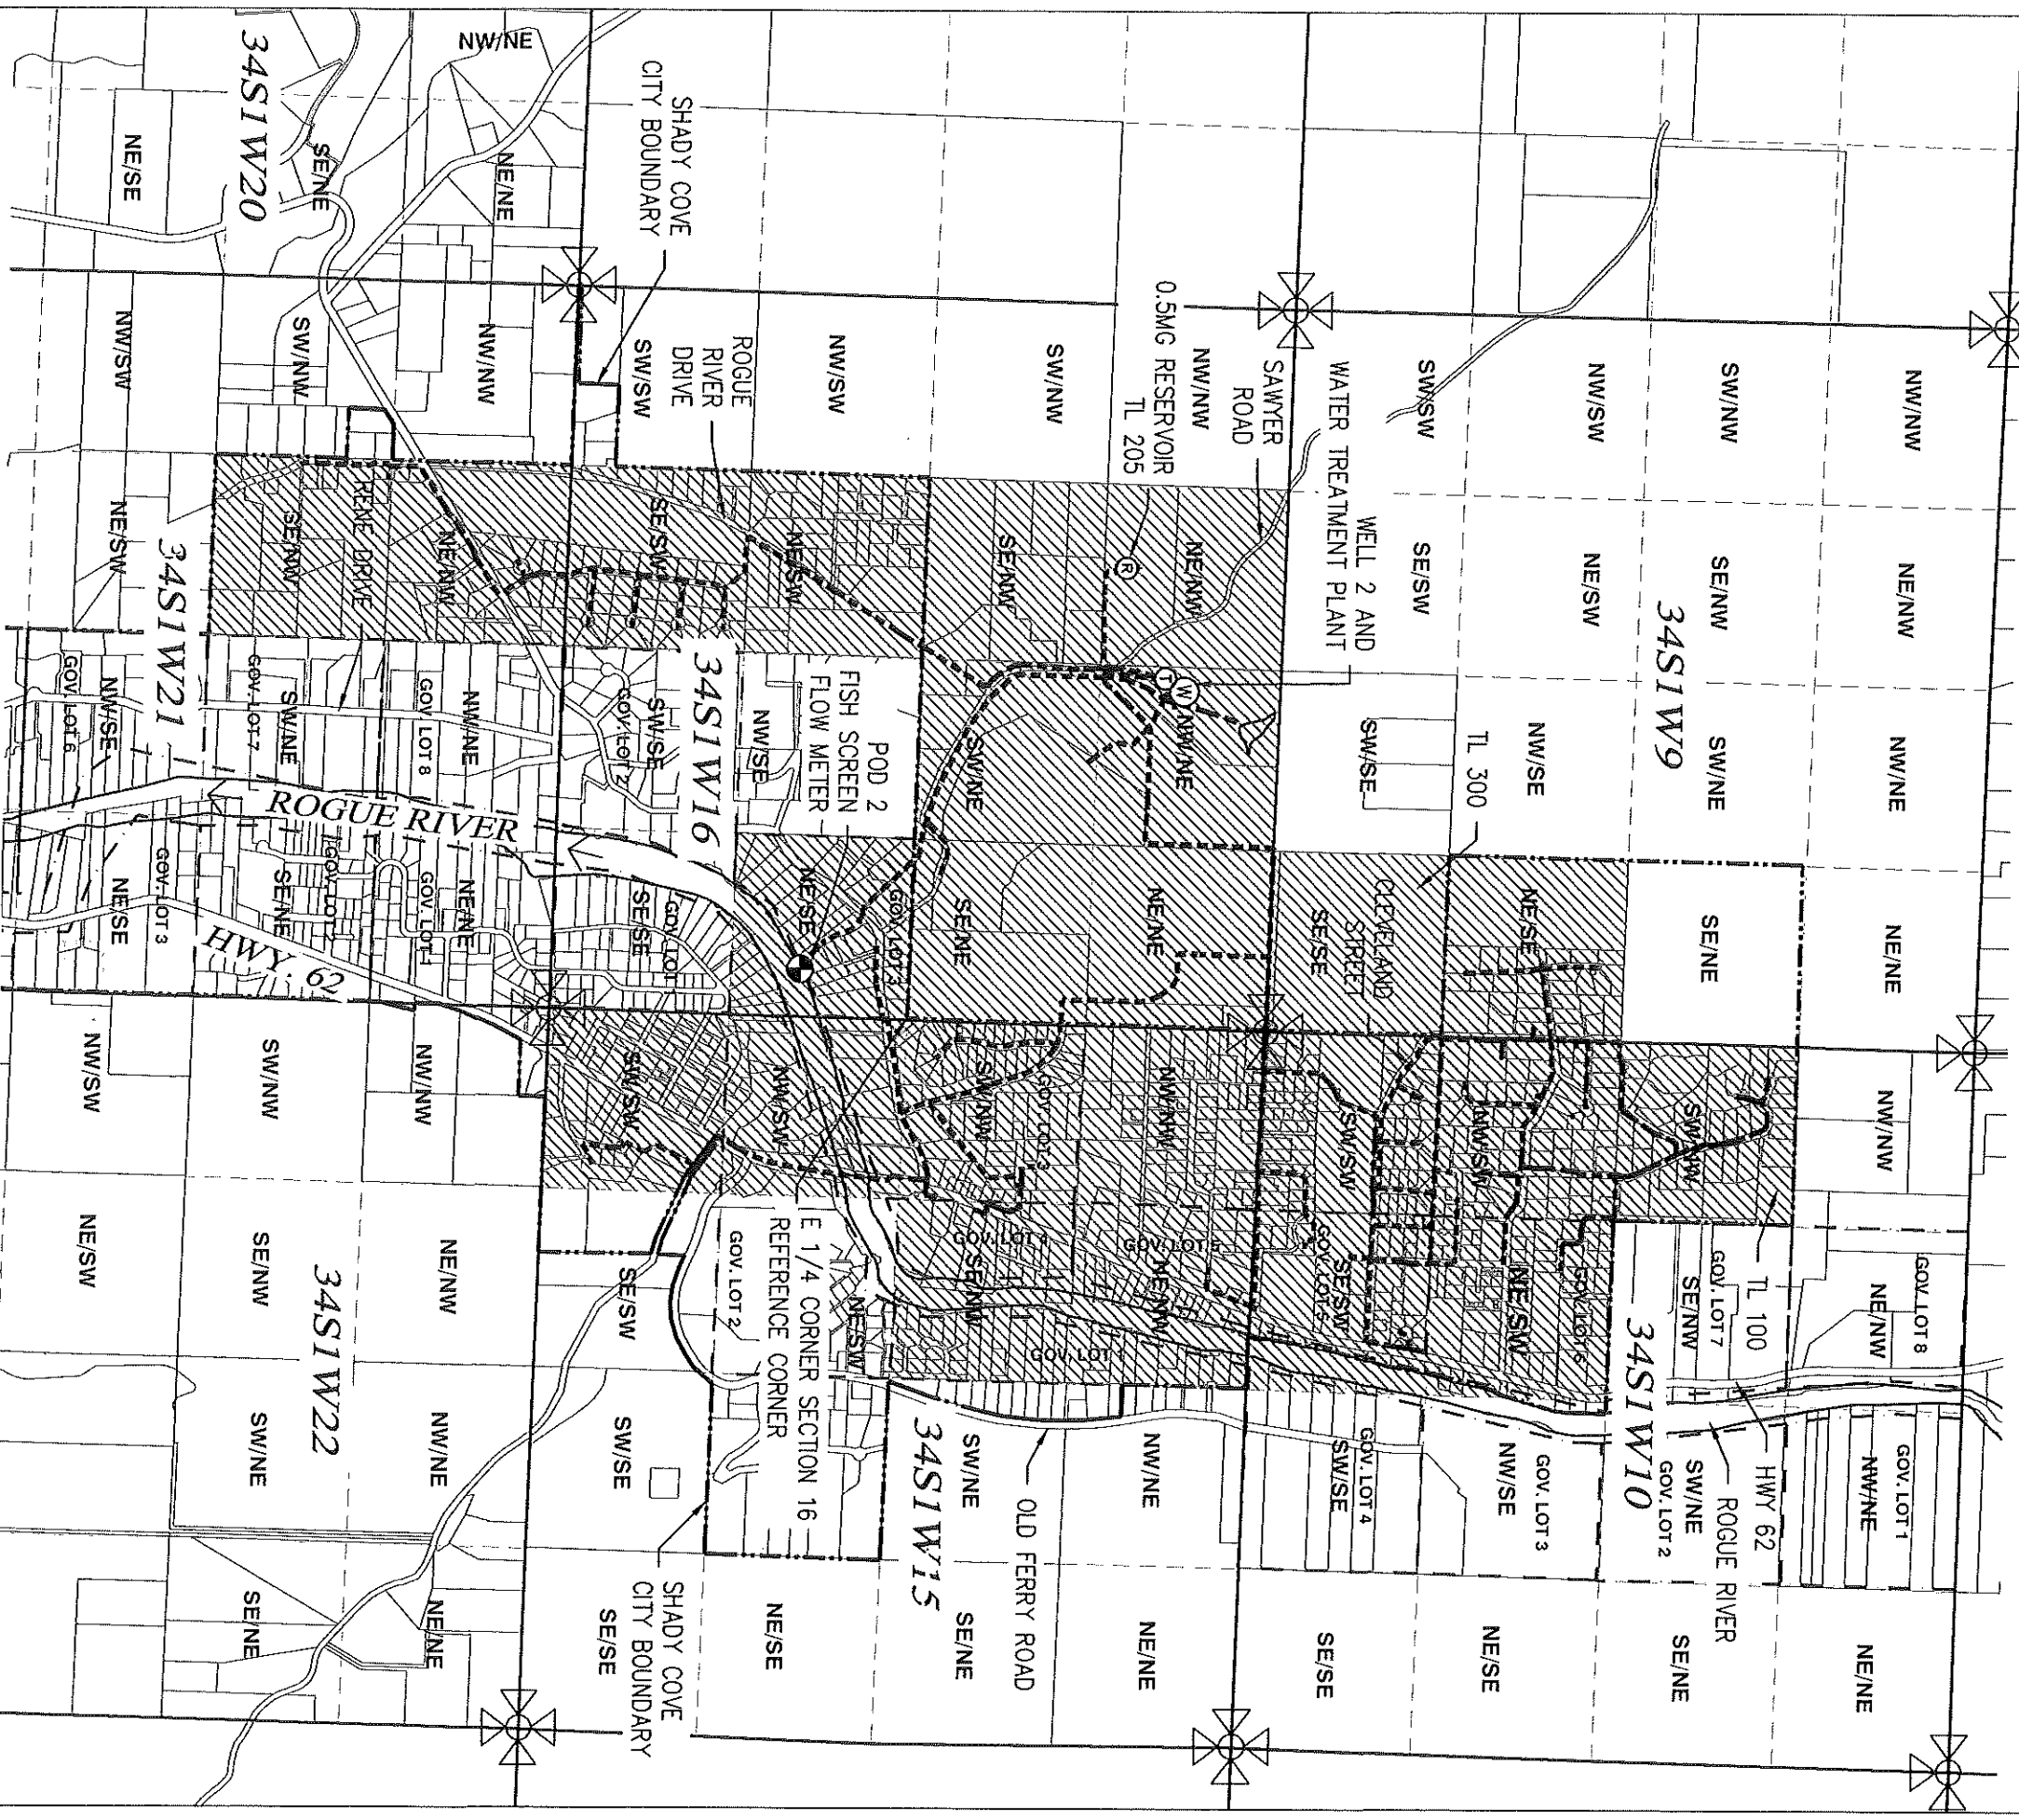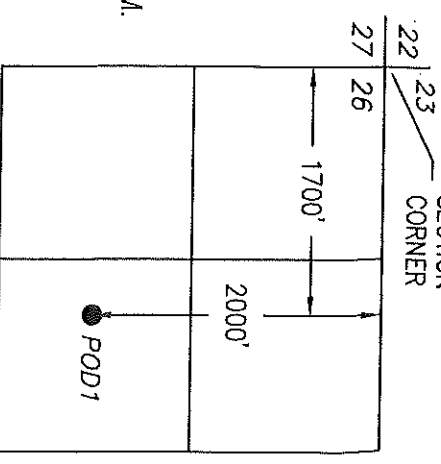

COBU MAP # 2156