


CLAIM OF BENEFICIAL USE MAP

TO CHANGE PLACE OF USE
PER APPLICATION T-14155
FOR LC & L PROPERTIES, LLC


TOWNSHIP 23 SOUTH, RANGE 31 EAST, SECTION 16, W.M.
TAX LOT 101

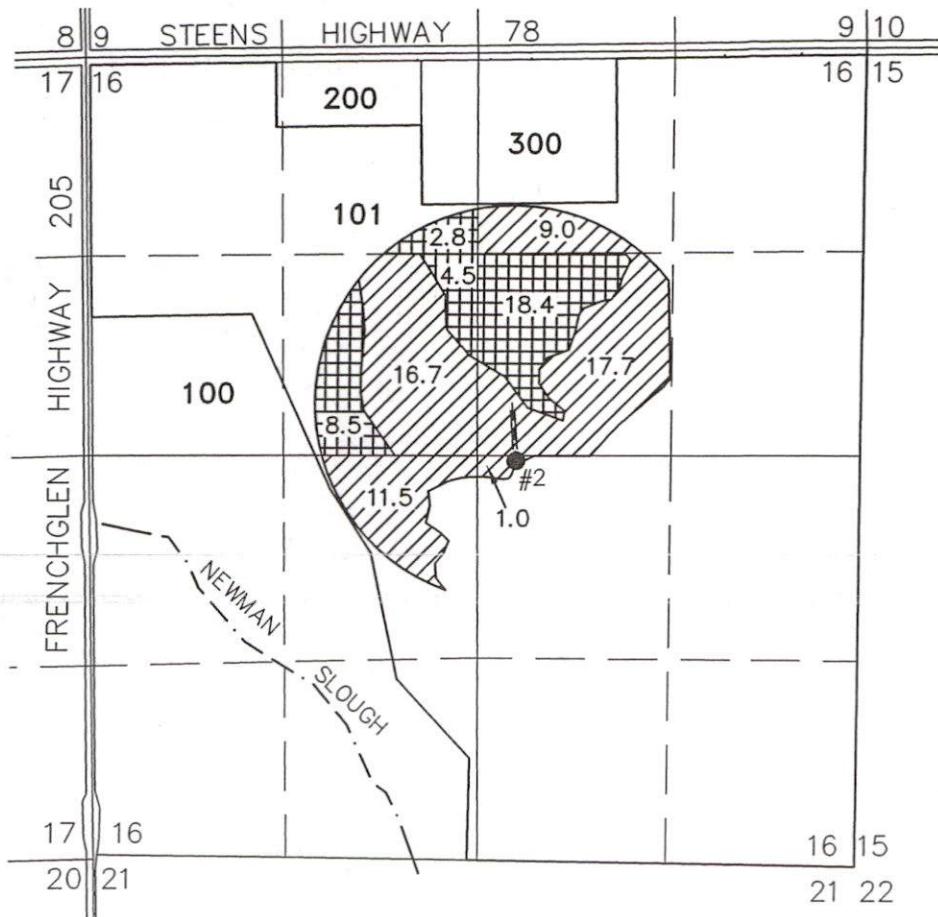

SCALE: 4 INCHES = 1 MILE

Received
OCT 14 2025

OWRD

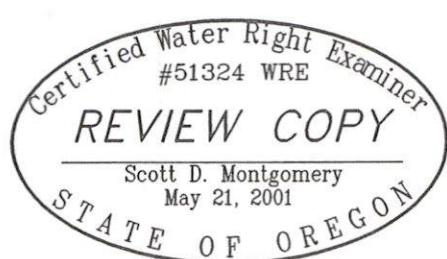

RENEWAL DATE: 12/31/2026

THIS MAP IS FOR THE PURPOSE OF LOCATING A
WATER RIGHT ONLY AND HAS NO INTENT TO
PROVIDE LEGAL DIMENSIONS OR THE LOCATION OF
PROPERTY LINES

BURIED CONDUIT

CREEK/STREAM

● WELL #2 (HARN 463)

AUTHORIZED WELL IN THE NW 1/4 SE 1/4 SECTION 16,
T23S R31E, W.M. LOCATED 2780 FEET SOUTH AND
2910 FEET EAST FROM THE NW CORNER OF SECTION 16.
METER IS APPROXIMATELY 8.0 FEET N'LY ALONG
DELIVERY PIPE FROM WELL.


34.2 ACRES IS FROM
T-14180, AS SHOWN.

55.9 ACRES IS FROM
T-14180, AS SHOWN.

PREPARED FOR:

LCL PROPERTIES, LLC
P.O. BOX 340
BURNS, OR 97720

PREPARED BY:

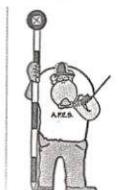

ALL POINTS ENGINEERING AND SURVEYING, INC.
P.O. BOX 767
(541) 548-5833
TERREBONNE, OR 97760
www.APEandS.com