


TOWNSHIP 1 SOUTH RANGE 44 EAST

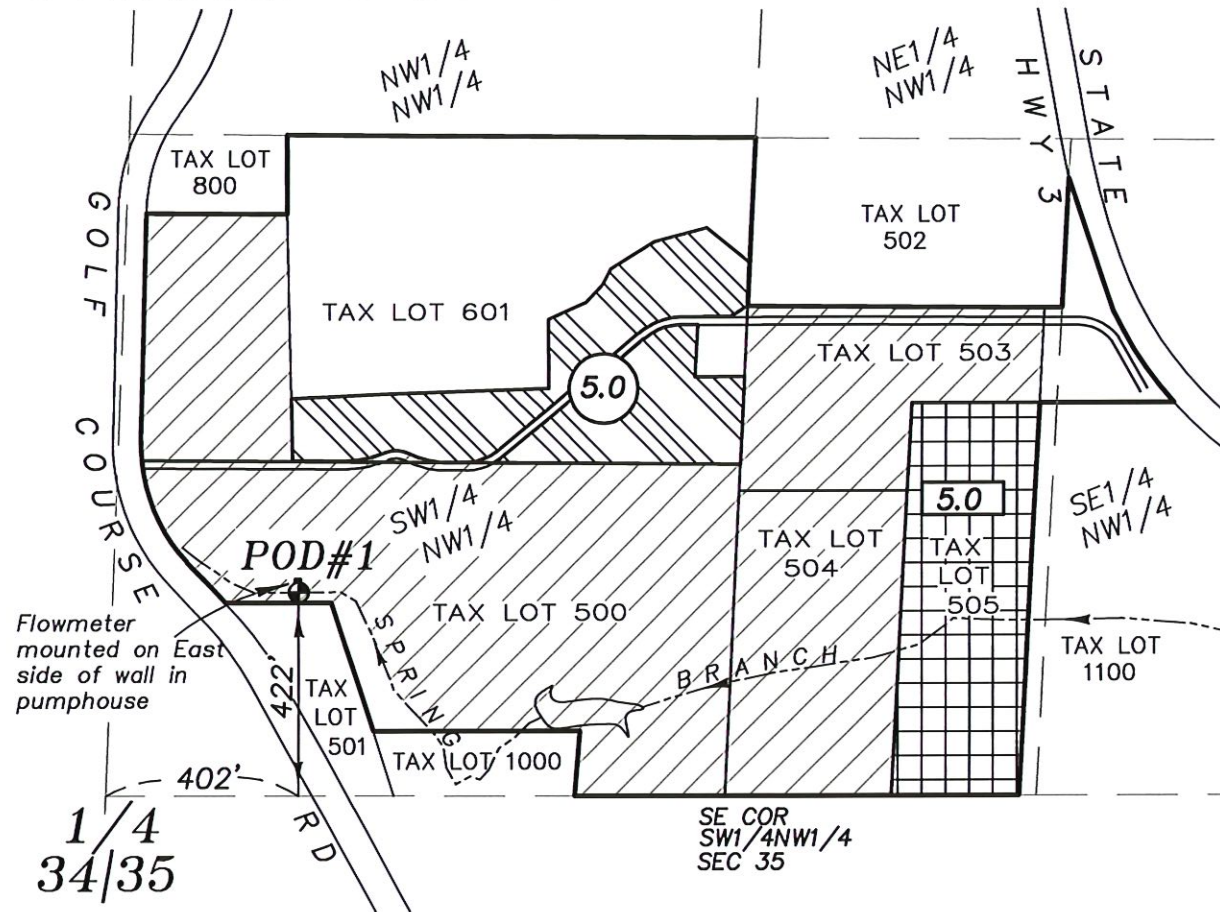

October 3, 2025

FINAL PROOF FOR TRANSFER OF PLACE OF USE

FOR
OPAL ASSETS MANAGEMENT, LLC

BY
BAGETT, GRIFFITH AND BLACKMAN
2006 ADAMS AVE
LA GRANDE, OREGON 97850

LEGEND



Place of use of Certificate 41280 (priority date Feb.11, 1969) to have rights transferred from



Lands to which place of use to be transferred to



Portion of Certificate 41260 (priority date Feb.11, 1969) to remain in place



Authorized Point of Diversion



Area of water rights to be transferred



Area of land receiving water rights



Renews: June 30, 2027

NOTE: The preparation of this map was for the purpose of identifying the location of proposed water rights and is not intended to provide dimensions or location of property ownership lines. Location information hereon was furnished by the applicant.

SCALE: 1"=400'

APPLICATION NO. T-13945

PERMIT NUMBER

Received
OCT 14 2025
OWRD