

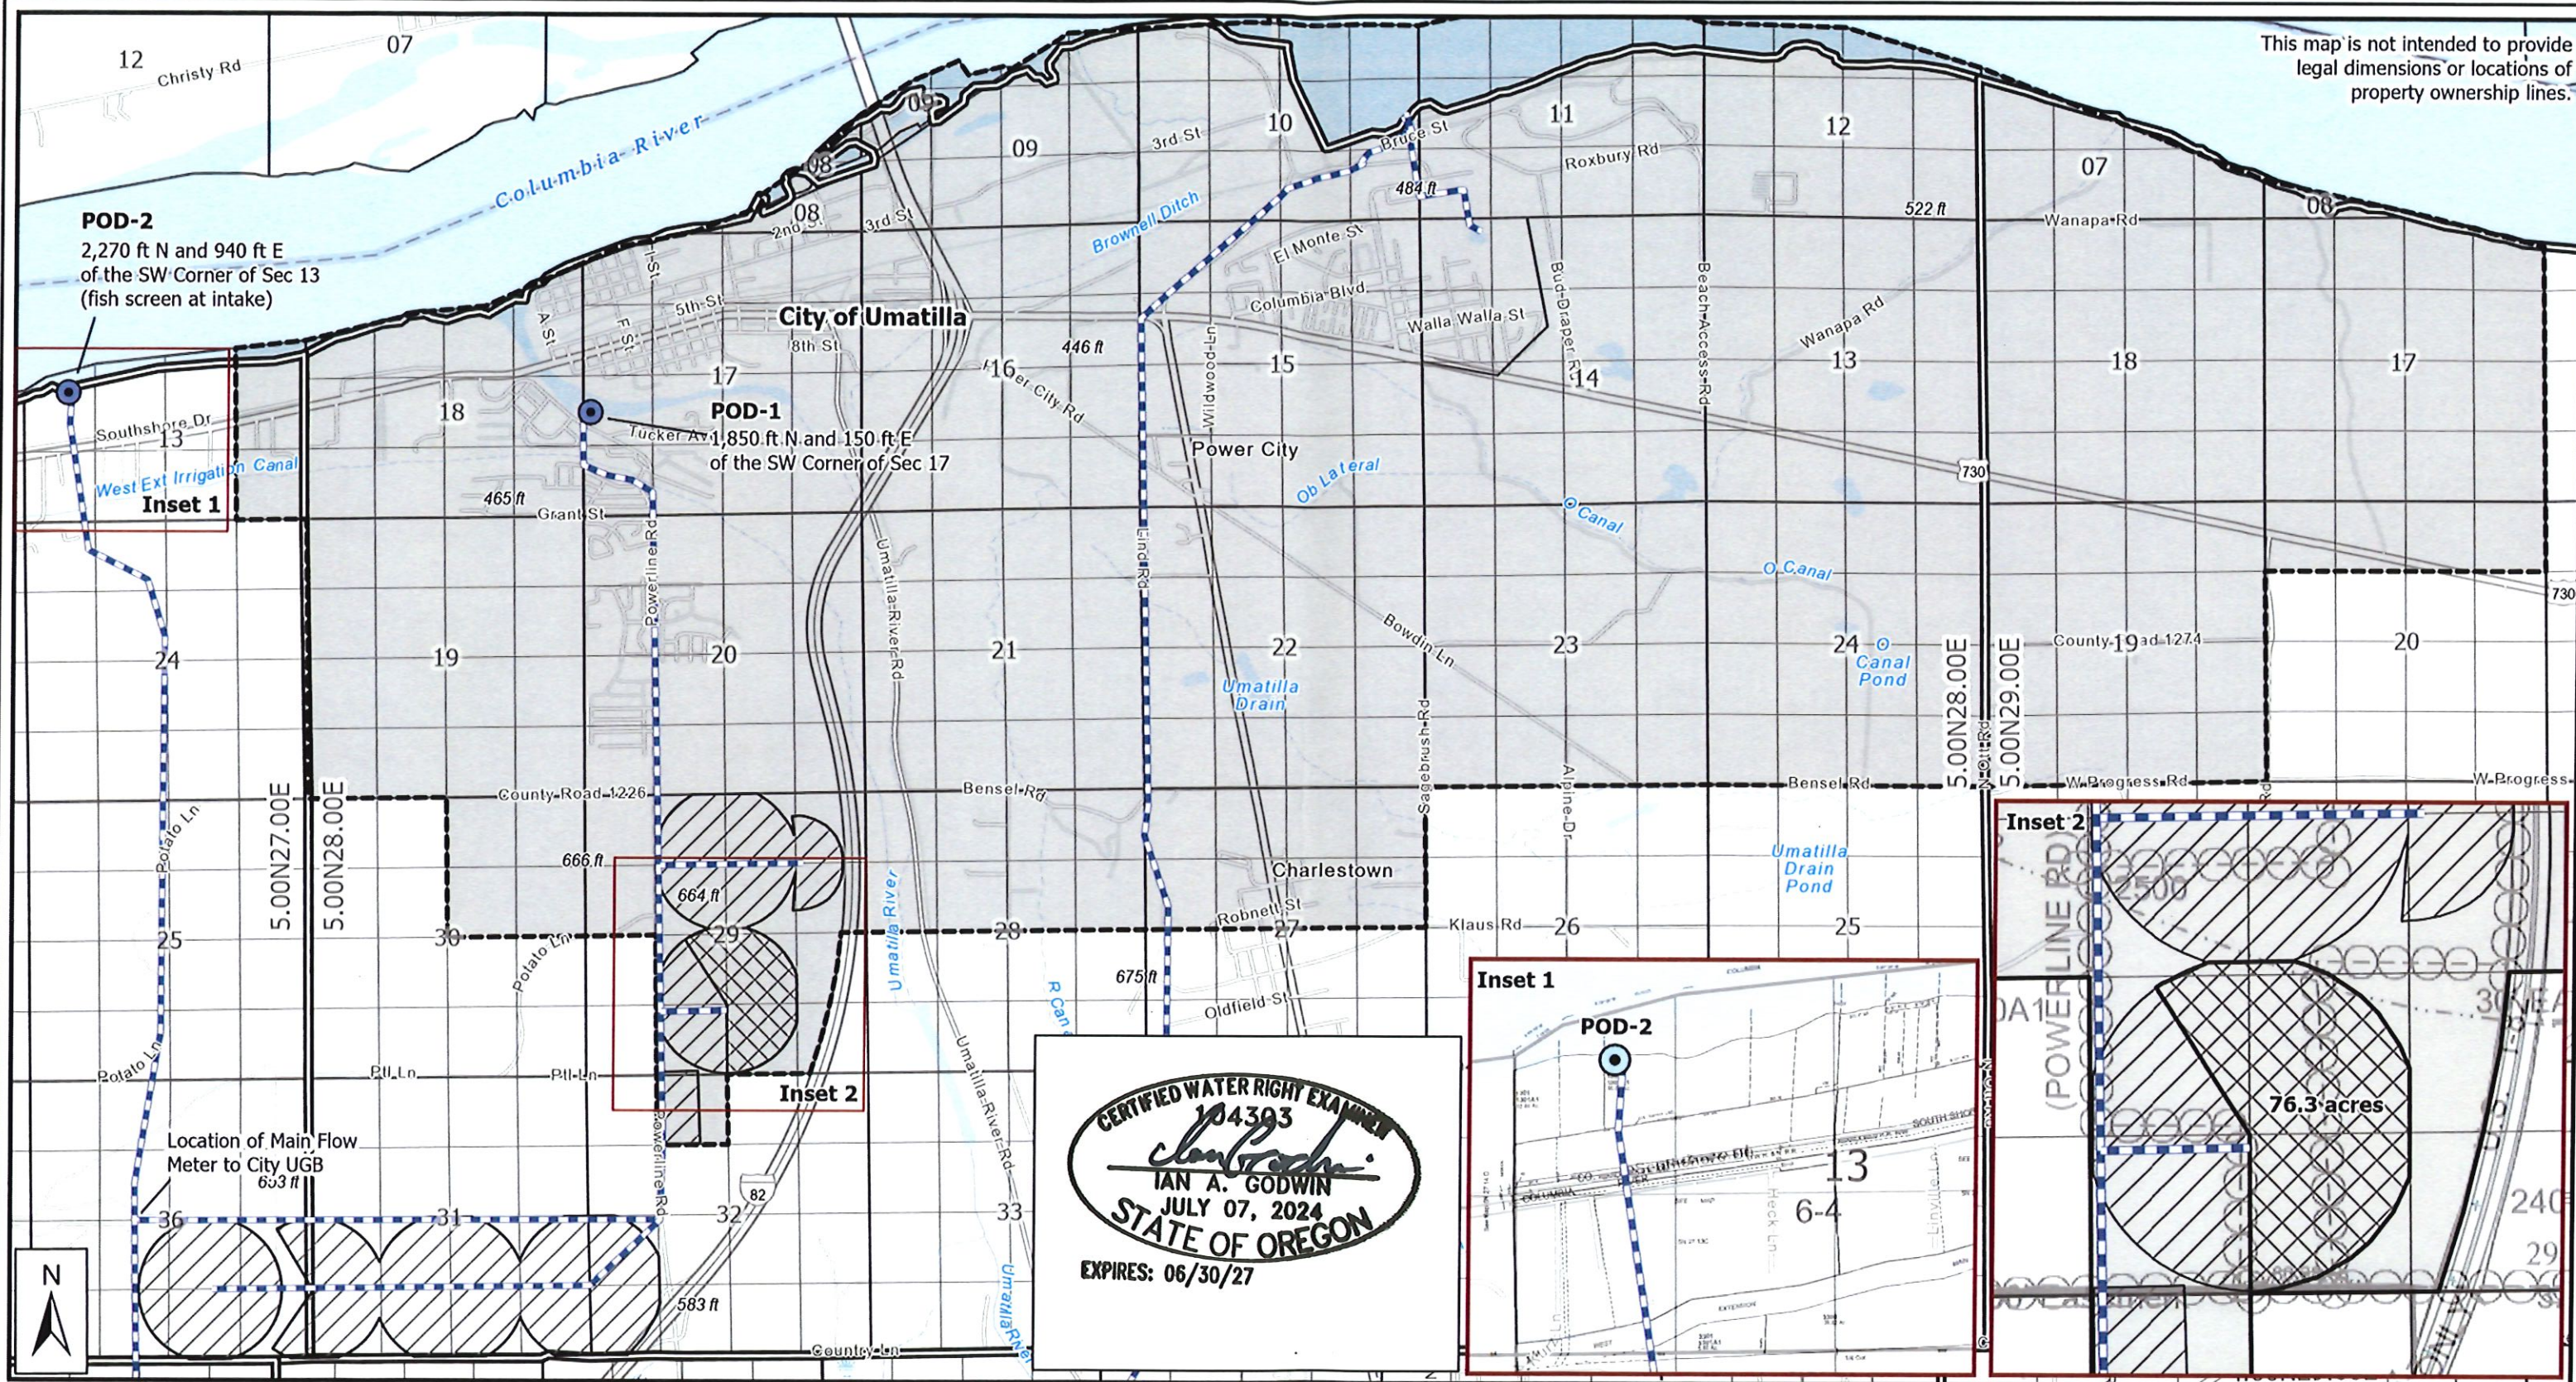


This map is not intended to provide legal dimensions or locations of property ownership lines.

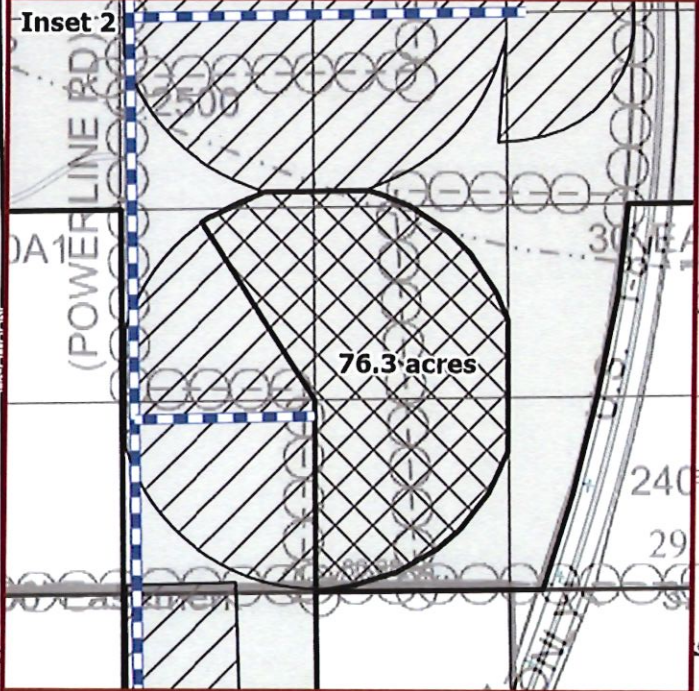


CERTIFIED WATER RIGHT EXAMINER
104393
IAN A. GODWIN
JULY 07, 2024
STATE OF OREGON
EXPIRES: 06/30/27

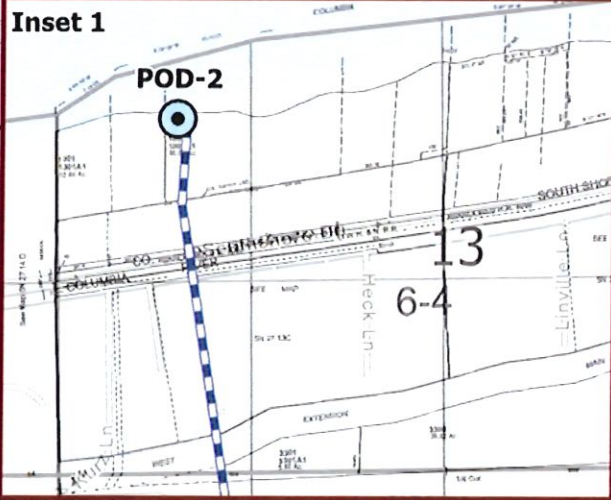

311 B Avenue, Suite P
Lake Oswego, Oregon 97034
(503) 954-1326

ATTACHMENT 1
TRANSFER T-14099 CLAIM OF BENEFICIAL USE
T5N, R27E, Sec. 13, T5N, R28E, Sec. 8-24, 27-30, 32,
T5N, R29 E, Sec. 7-8, 17-20

1	DATE	AUTHOR	DRAFT

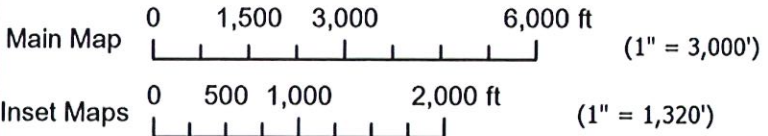

Proj#: 2013004
Umatilla Transfer I
City of Umatilla
700 6th Street
Umatilla, OR 97882

- Points of Diversion
- Water Distribution Lines
- City Service Area / "To" Lands
- Cert. 53653 "From" Lands
- Cert. 53653 POU

Received
OCT 15 2025
OWRD