

Approved:



MEMO

To: Kristopher Byrd, Well Construction Manager
From: Tommy Laird, Well Construction Program Coordinator
Subject: Rereview of Water Right Application G-19433
Date: October 14, 2025

The attached application was forwarded to the Well Construction Section by the Groundwater Section. Stacey Garrison reviewed the application. Please see Stacey's Groundwater Review and the Well Reports.

Applicant's Well #1 (MARI 2242/MARI 71846): Based on a review of the Well Reports, Applicant's Well #1 seems to protect the groundwater resource.

The construction of Well #1 may not satisfy hydraulic connection issues

Applicant's Well #2 (MARI 71275): Based on a review of the Well Report, Applicant's Well #2 seems to protect the groundwater resource.

The construction of Well #2 may not satisfy hydraulic connection issues.

MARR 2242

55/2w/2ac
8659

Well Number: 2821

(9) LOCATION OF WELL by legal description:

Street Address of Well (or nearest address) 17049 Mt. View Lane N.E. Woodburn, OR

☒ New Well ☐ Deepen ☐ Recondition ☐ Abandon

☒ Rotary Air ☐ Rotary Mud ☐ Cable
☐ Other _____

☒ Domestic ☐ Community ☐ Industrial ☐ Irrigation
☐ Thermal ☐ Injection ☐ Other _____

Special Construction approval Yes ☐ No ☒ Depth of Completed Well 127 ft.

Explosives used Yes ☐ No ☒ Type _____ Amount _____

How was seal placed: Method ☐ A ☐ B ☐ C ☐ D ☐ E
☐ Other As Per 690-210-340

Backfill placed from _____ ft. to _____ ft. Material _____
Gravel placed from _____ ft. to _____ ft. Size of gravel _____

	Diameter	From	To	Gauge	Steel	Plastic	Welded	Threaded
Casing:	6"	0	127	.250	☒	☐	☒	☐
					☐	☐	☐	☐
					☐	☐	☐	☐
					☐	☐	☐	☐
Liner:					☐	☐	☐	☐
					☐	☐	☐	☐

Final location of shoe(s) 127'

☒ Perforations Method Torch
☐ Screens Type _____ Material _____

[illegible]

☐ Pump ☐ Bailer ☒ Air ☐ Flowing Artesian

Yield gal/min	Drawdown	Drill stem at	Time
100+	83	127	1 hr.

Temperature of water _____ Depth Artesian Flow Found _____

Was a water analysis done? ☐ Yes By whom _____

Did any strata contain water not suitable for intended use? ☐ Too little

☐ Salty ☐ Muddy ☐ Odor ☐ Colored ☐ Other _____

Depth of strata: _____

44 ft. below land surface. Date 7/10/89
Artesian pressure _____ lb. per square inch. Date _____

Depth at which water was first found 72

From	To	Estimated Flow Rate	SWL
72	127	100+	44

Ground elevation

[illegible]

Date started XXX 7/10/89 Completed 7/10/89

(unbonded) Water Well Constructor Certification:

I certify that the work I performed on the construction, alteration, or abandonment of this well is in compliance with Oregon well construction standards. Materials used and information reported above are true to my best knowledge and belief.

Signed Mark D. Bier WWC Number 753
Date 7/10/89

(bonded) Water Well Constructor Certification:

I accept responsibility for the construction, alteration, or abandonment work performed on this well during the construction dates reported above. all work performed during this time is in compliance with Oregon well construction standards. This report is true to the best of my knowledge and belief. **Willamette Drilling co.** WWC Number 753
Signed Mark D. Bair Date 7/10/89

MARI 2242
For Official Use Only:

Received Date:

4-29-98

County Well Log ID #

MARI 2242

Well Identification Tag #

24692

WELL IDENTIFICATION APPLICATION FORM

BUYER/CURRENT WELL OWNER:

Name:

Terry Kieling

Mailing Address:

17049 Mtn. View Ln. NE

City:

Woodburn

State:

OR

Zip:

97071

Phone:

()

WELL LOCATION:

County:

Marion

Owner's Well Number:

Township:

5

N or S,

Range:

2

E or W,

Section:

2

1/4

SE

1/4

Tax Lot Number:

3400

Type of Well:

water supply

monitoring

Street Address of Well (if different from above):

17049 Mtn View Ln NE

Woodburn

97071

WELL INFORMATION: (do not complete remainder of application if well log is available)

Start Card Number:

Approx. Construction Date:

Well Constructor:

N/A

Name of Owner at Time of Construction:

Well Depth (in feet):

Static Water Level (in feet):

Diameter of Exposed Well Casing (in inches):

Does this well have a formal water right associated with it? Yes:

No:

If Yes: Application #:

Permit #:

Certificate #:

Please Return Completed Form to:

Lisa Juul

Well Identification Program

Oregon Water Resources Department

158 12th Street NE

Salem, OR 97310

* Tagged Dicked
up by Realtor
4-29-98


Casing height extension only to meet water right requirement for application G-19433. The well log on file MARI 2242 has a well ID tag application attached with #24692. No tag was on well so new tag was attached #L-156270

WATER SUPPLY WELL REPORT - Map with location identified must be attached and shall include an approximate scale and north arrow

MARI 71846

10/6/2025

Map of Hole

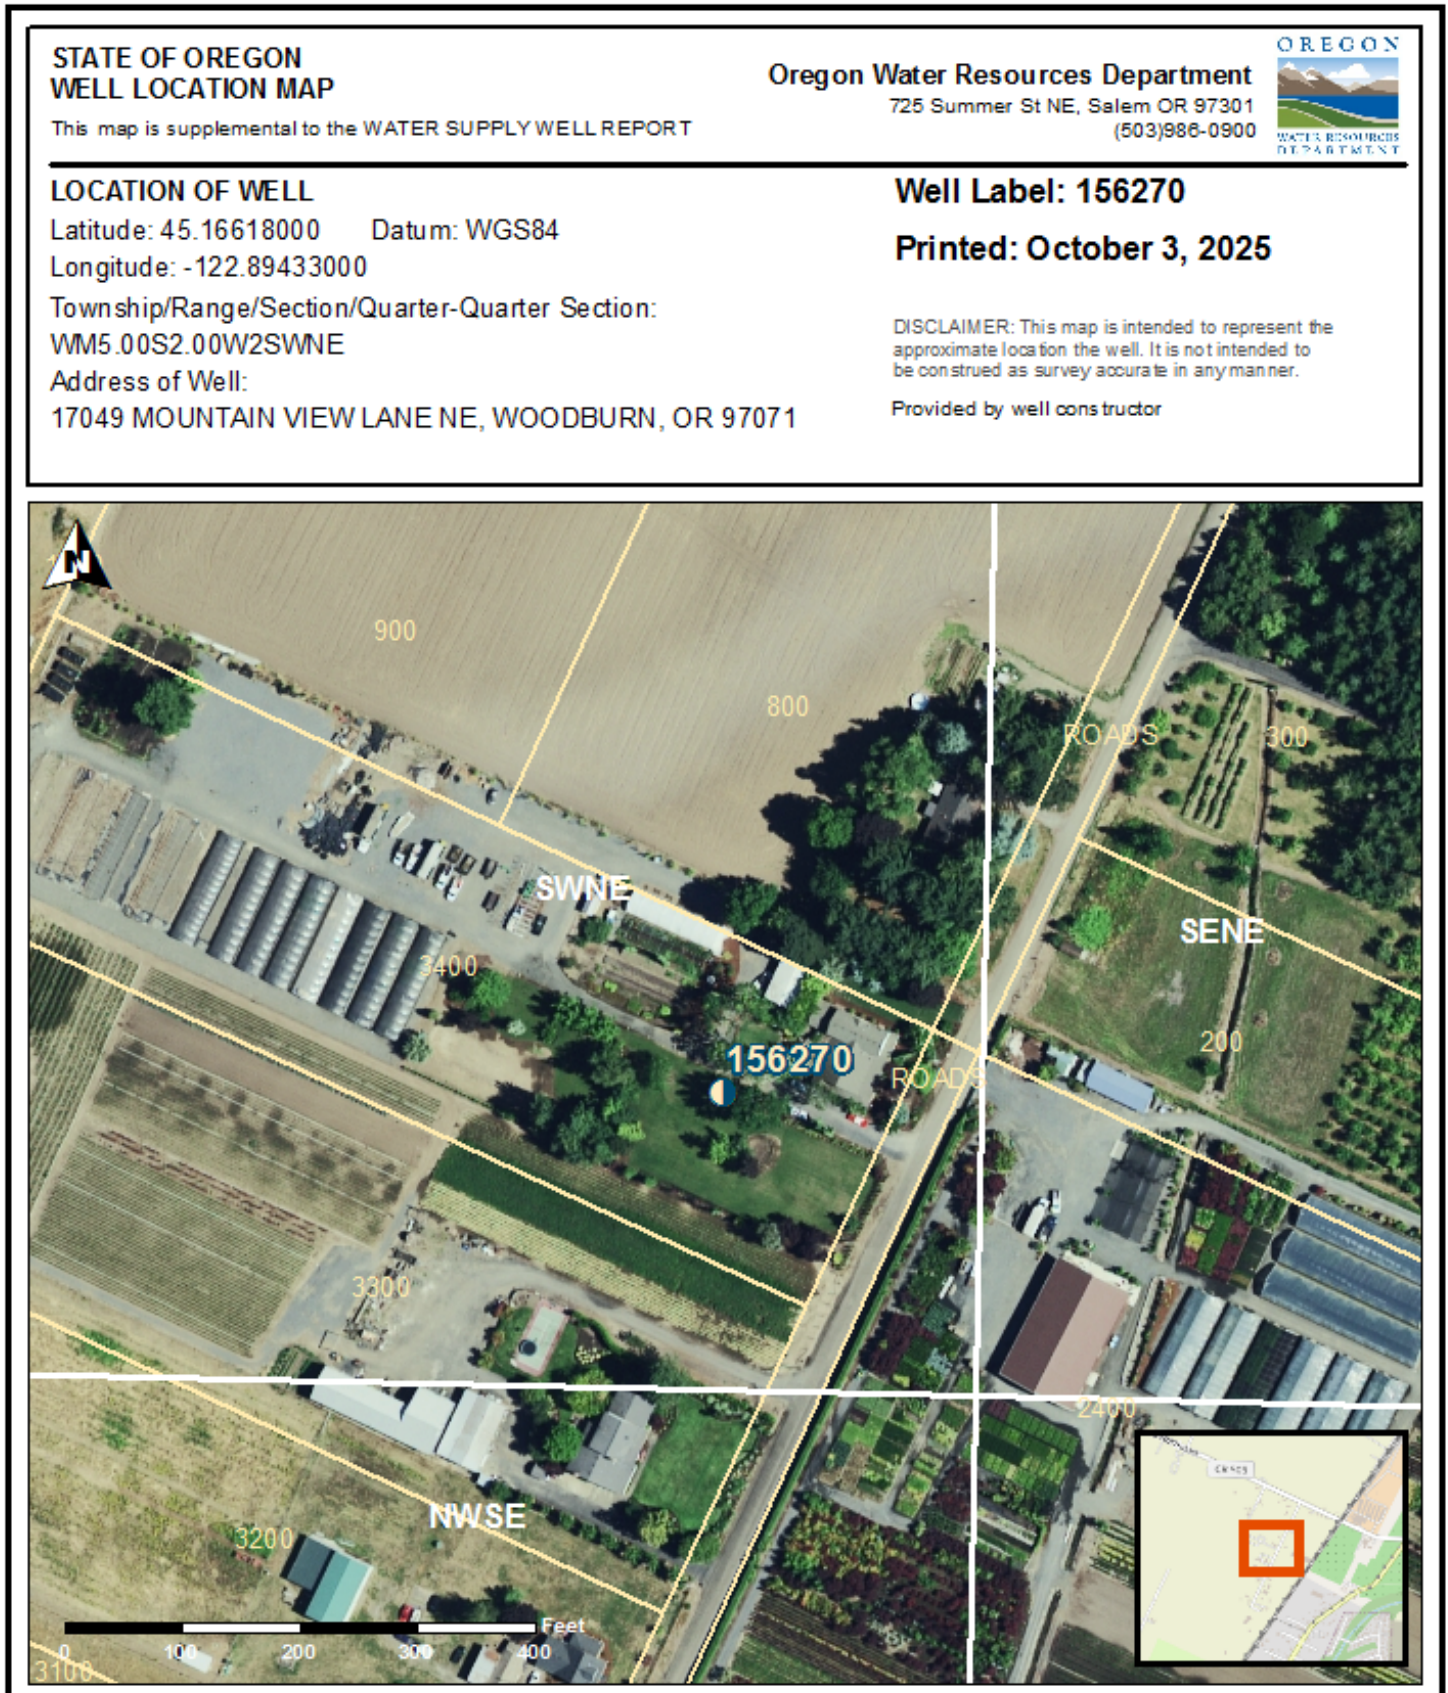

WATER SUPPLY WELL REPORT -
continuation page

WESTERBERG DRILLING INC.^W
PO BOX 1228

WELL I.D. LABEL# L
C. START CARD #
ORIGINAL LOG #

151660
1073849

(2a) PRE-ALTERATION

Dia	+	From	To	Gauge	Stl	Plstc	Wld	Thrd
								
								
								

Material	From	To	Amt	sacks/lbs
				
				
				

(5) BORE HOLE CONSTRUCTION

BORE HOLE			SEAL			sacks/ lbs	
Dia	From	To	Material	From	To		Amt
					Calculated		
					Calculated		
					Calculated		
					Calculated		
					Calculated		

FILTER PACK				
From	To	Material	Size	
				
				
				

(6) CASING/LINER

[illegible]

(7) PERFORATIONS/SCREENS

[illegible]

(8) WELL TESTS: Minimum testing time is 1 hour

Yield gal/min	Drawdown	Drill stem/Pump depth	Duration (hr)

MOLALLA, Water Quality Concerns

From	To	Description	Amount	Units

(10) STATIC WATER LEVEL

[illegible]

(11) WELL LOG

[illegible]

Name of person(s) who assisted with construction and Trainee License # / Helper #

Assistant Name	Type	#
Cody Stephenson	Assist	

Comments/Remarks

56 sacks of 8/12 sand

Received

JUN 24 2024

OWRD

Step 1: Search for Well

Step 2: Create Well Map

Mark Well Point and Create Map:

Zoom in closer to the well location, if needed.
Mark the location of the well by either of these 1

A. Drawing on the map using the draw tool

Click on Icon and draw a point on the map

B. Type in the GPS Decimal Degrees:

GPS Latitude: 45.16790

GPS Longitude: -122.89569

Mark Point Clear Point

[Converter](#)

Results:

Latitude: 45.16790 Longitude: -122.89569

Complete the form:


Submitted by: Steve Stadel #688

Address of Well: 17200 Harmony Lane

City: Woodburn

Special Notes: L151660

Make Map

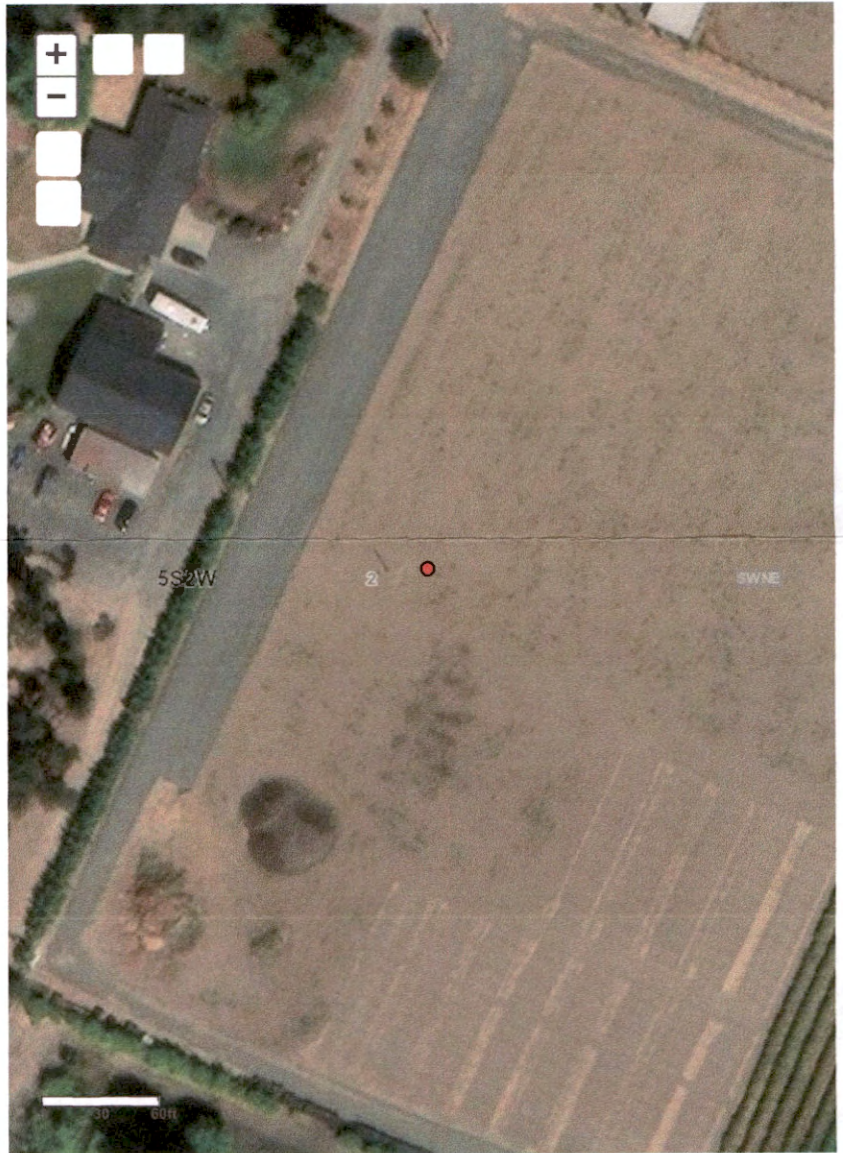

Received
JUN 24 2024
OWRD