


DATE OF SURVEY: SEPTEMBER 10, 2025


SCALE: 1" = 400'

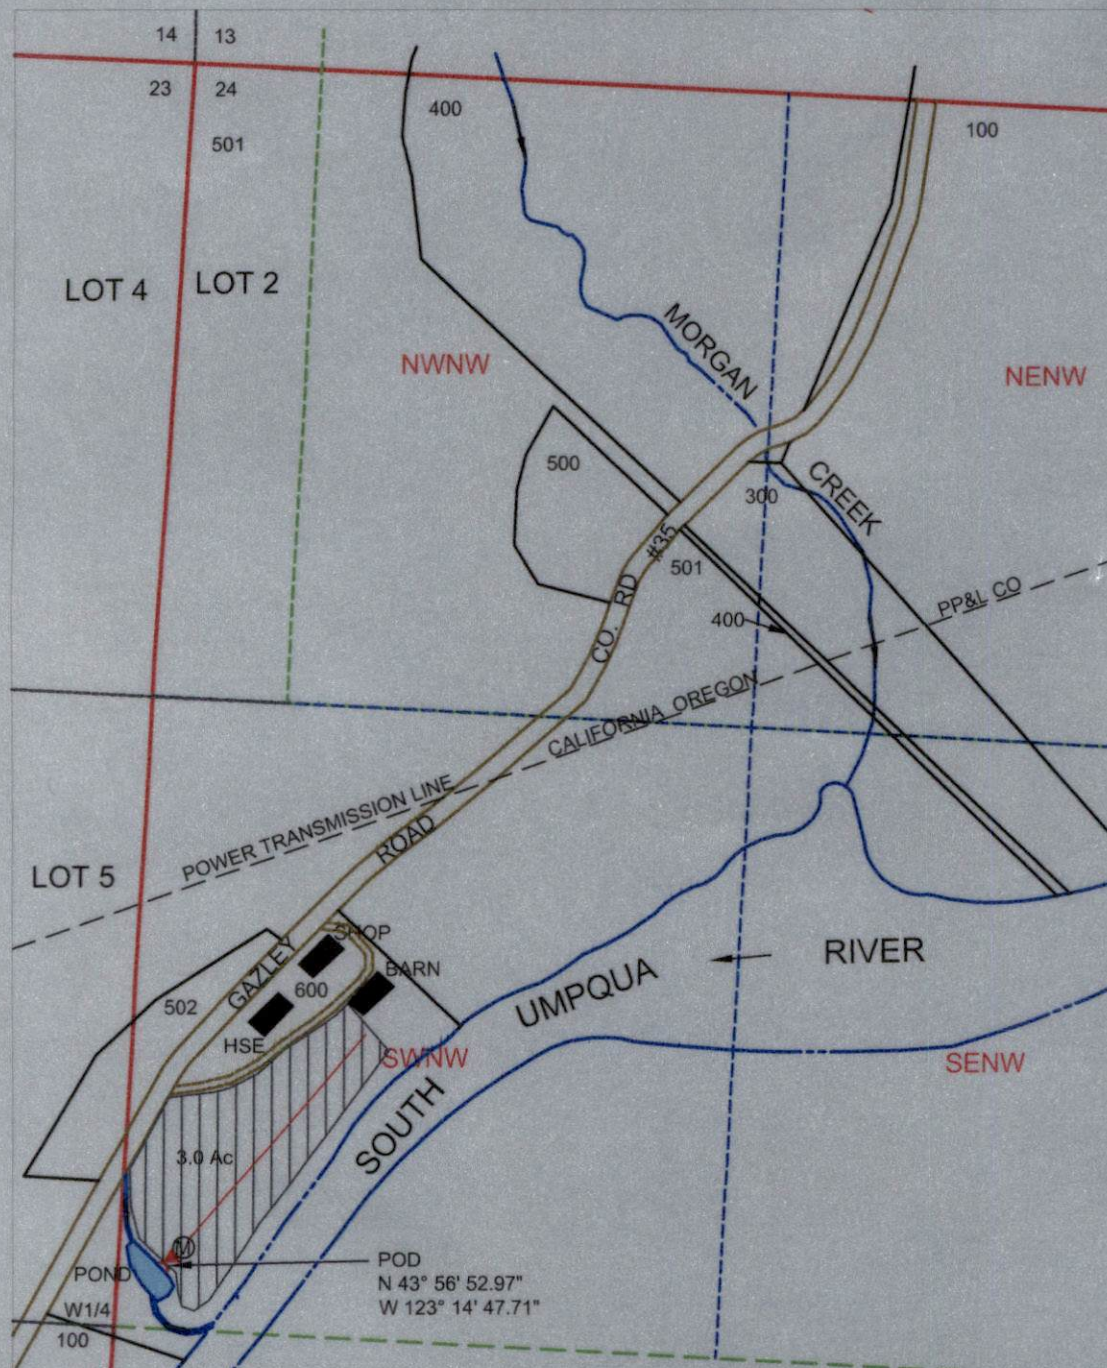

LEGEND

POD
METER
PUMP
IRRIGATION AREA
PIPELINE
SECTION
QUARTER
SIXTEENTH
DLC
GOV LOT
PARCEL
WATER

Received
OCT 20 2025
OWRD

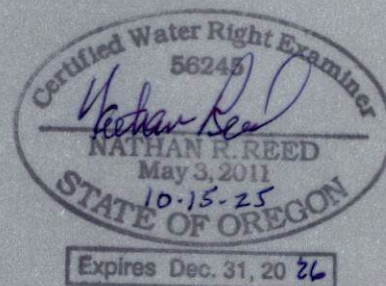

POD IS LOCATED 120 FEET NORTH AND 100 FEET EAST FROM W1/4 CORNER, SECTION 14.

MAP PREPARED BY:
NATHAN REED PE, CWRE
157 WEST BODIE STREET
ROSEBURG, OR 97471

MAP PREPARED FOR:
BRUCE & DONNA VAN KLAVEREN
5319 GAZLEY ROAD
MYRTLE CREEK, OR 97457