


FOR: NARALTO, LLC
BY: NATHAN REED, PE, CWRE
T26S, R3W, W.M. SECTION 10
TRANSFER NO. T-13755

SCALE: 1" = 400'

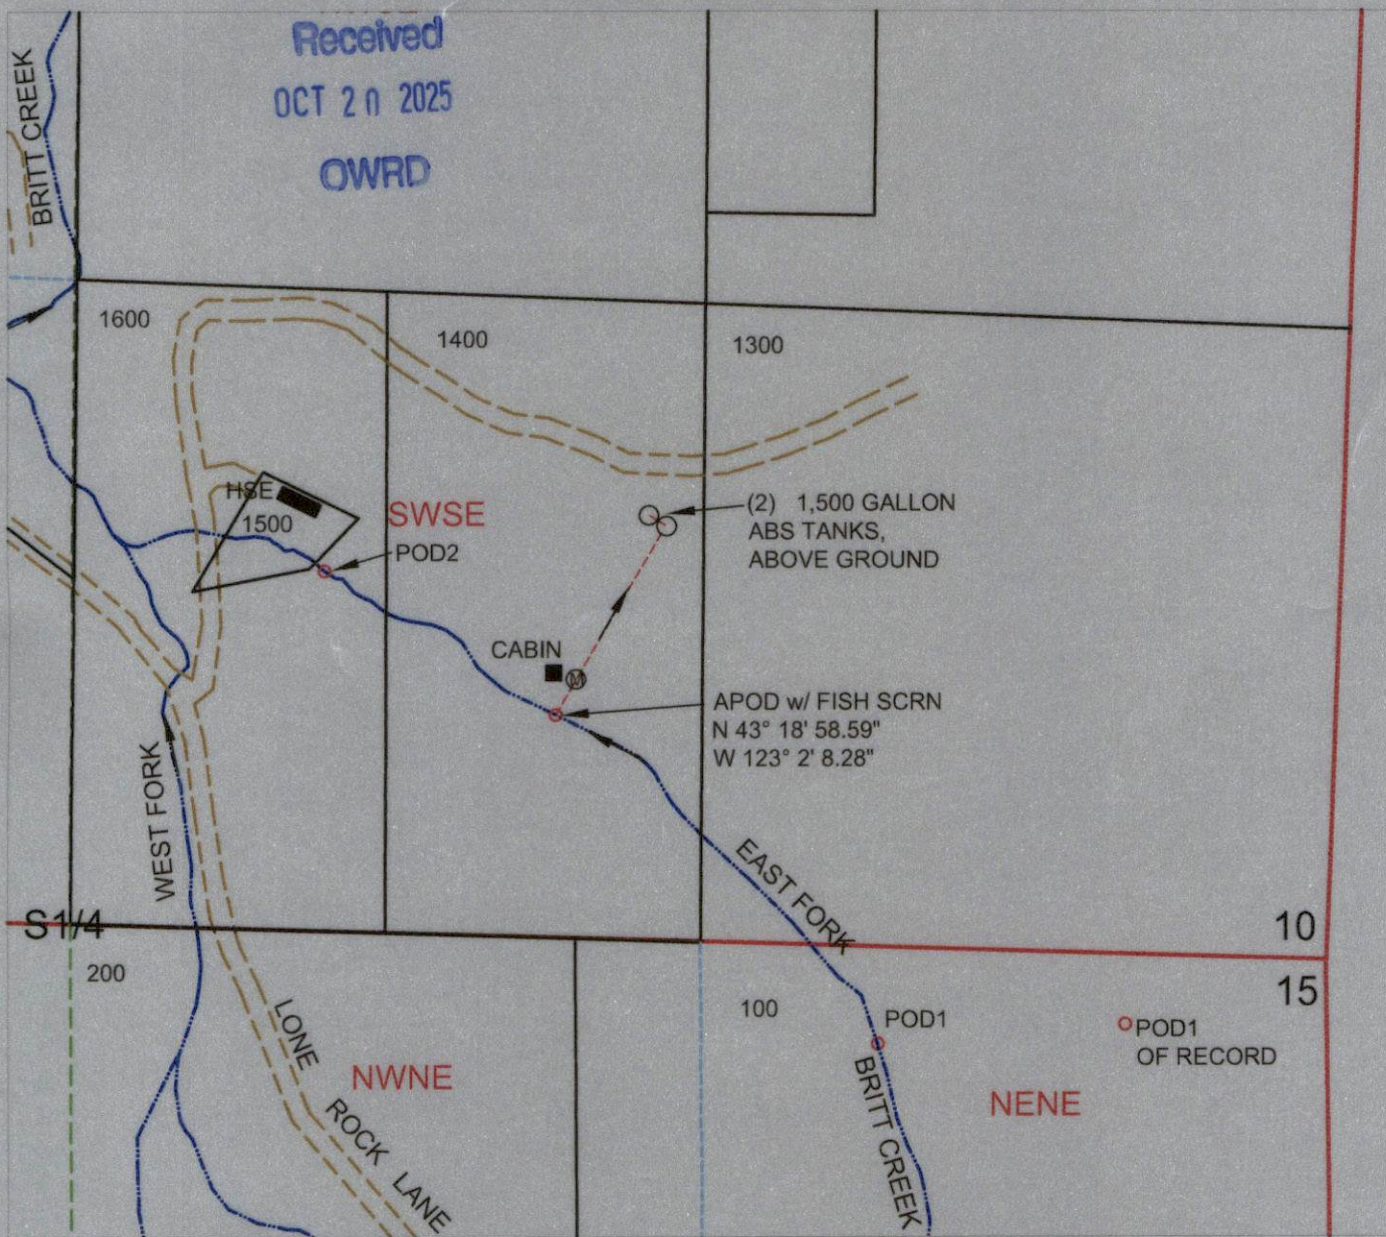

APOD IS LOCATED 315 FEET NORTH & 1200 FEET EAST OF S1/4 CORNER OF SECTION 10.

MAP PREPARED BY:
NATHAN REED PE, CWRE
157 WEST BODIE STREET
ROSEBURG, OR 97471



WATER
POD
METER
PIPE

QUARTER
SIXTEENTH
PARCEL
IRRIGATION

THE PURPOSE OF THIS MAP IS TO IDENTIFY THE LOCATION OF THE WATER RIGHT. IT IS NOT INTENDED TO PROVIDE INFORMATION RELATIVE TO THE LOCATION OF PROPERTY OWNERSHIP BOUNDARY LINES.

