

CLAIM OF BENEFICIAL USE MAP

APPLICATION: G-18575, PERMIT: G-18353 - PRIORITY DATE 11/2/2017

IRRIGATION

FOR

JACK ROZEWICZ

KNOWNOT LLC


3350 BEAGLE ROAD

WHITE CITY, OR 97503

SITUATED IN

SECTION 18, TOWNSHIP 35 SOUTH, RANGE 1 WEST, W.M.

JACKSON COUNTY, OREGON

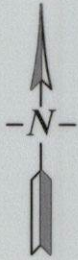


0 200 400

SCALE: 1"=400'

LEGEND

- **WELL 1 (L-138615)**
PUMP AND FLOW METER
1963' SOUTH AND 426' EAST
OF NW CORNER SECTION 18.
- ⊙ **WELL 2 (L-153560)**
PUMP AND FLOW METER
1965' SOUTH AND 952' EAST
OF NW CORNER SECTION 18.

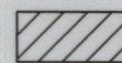

PLACE OF USE
IRRIGATION

----- 1/4-1/4 SECTION LINE

----- GOVERNMENT LOT
BOUNDARY


----- BURIED WATERLINE
(APPROXIMATE)

This map is not intended to
provide legal dimensions or
locations of property
ownership lines.

EHM-September 23, 2025

ROGUE CIVIL LLC

emalepsy@roguecivil.com 541-621-2868

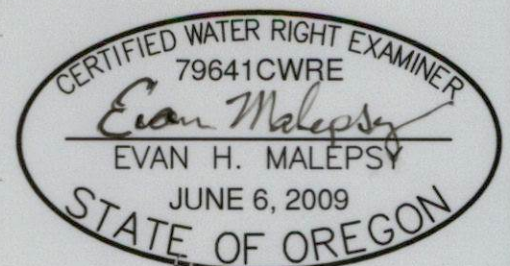

RENEWS: 12/31/2026

