


CLAIM OF BENEFICIAL USE MAP

TO ADD PLACE OF USE FOR STORAGE
PER APPLICATION R-35565
OREGON DEPARTMENT OF STATE LANDS

NE 1/4 SECTION 21, TOWNSHIP 28 SOUTH, RANGE 36 EAST, W.M.
TAX LOT: 501, HARNEY COUNTY, OREGON

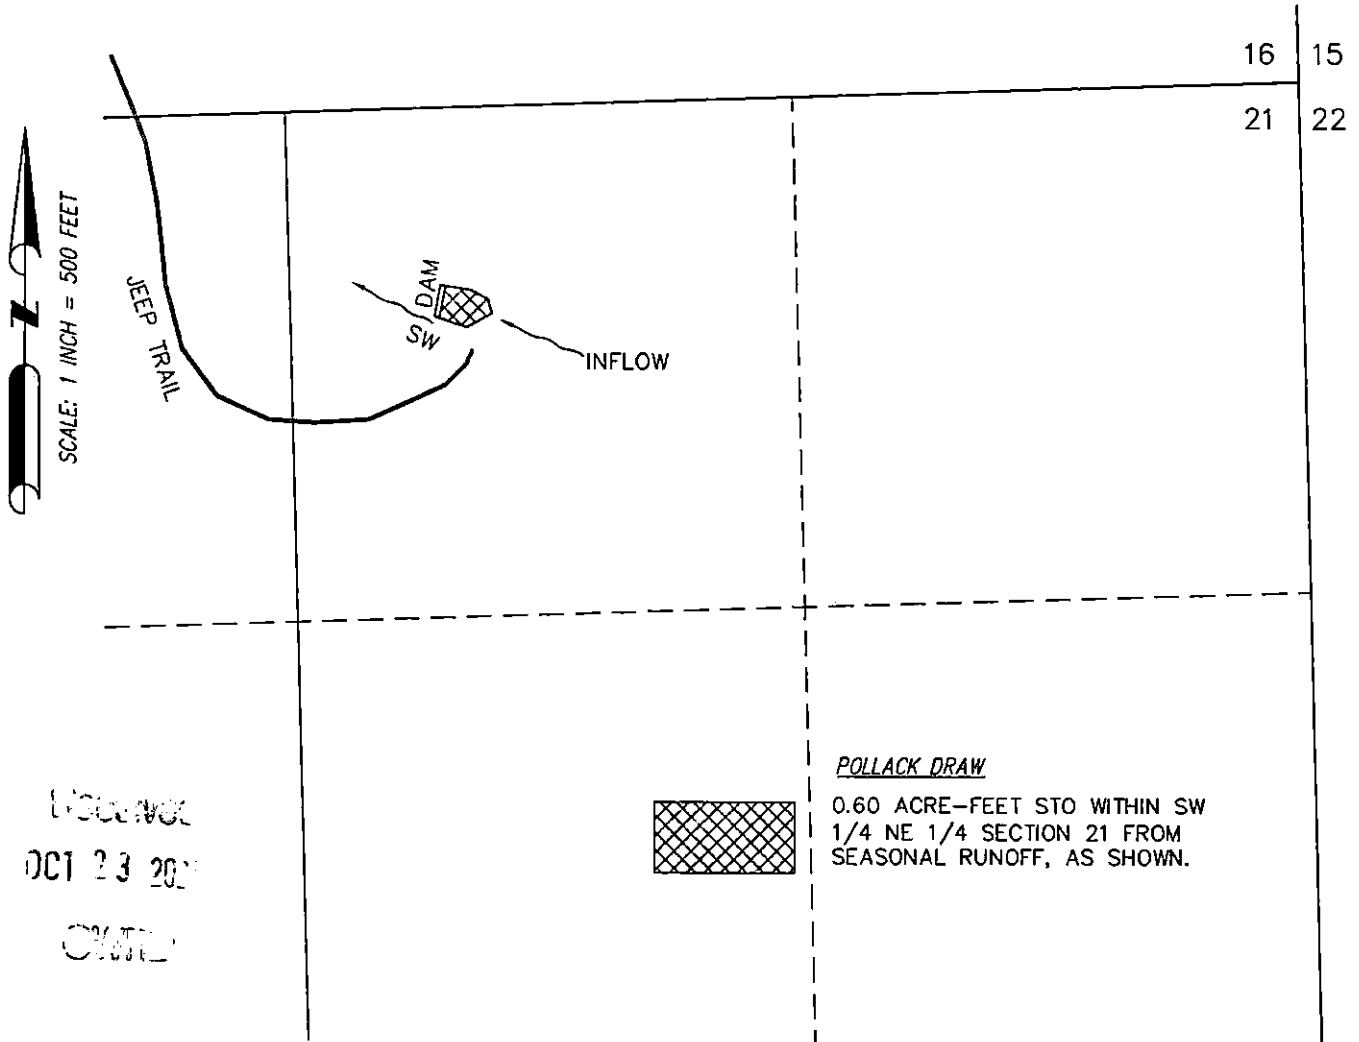

RECEIVED
OCT 23 2001
STATE



RENEWAL DATE: 12/31/2026

POD AT CENTER OF DAM IS LOCATED 500'
S & 380' E FROM 1/4 CORNER COMMON
TO SECTIONS 16 & 21.

THIS MAP IS FOR THE PURPOSE OF LOCATING A WATER RIGHT ONLY AND HAS NO
INTENT TO PROVIDE LEGAL DIMENSIONS OR THE LOCATION OF PROPERTY LINES.

PREPARED FOR:

OREGON DEPARTMENT OF STATE LANDS
775 SUMMER STREET NE #100
SALEM, OR 97301

PREPARED BY:



ALL POINTS ENGINEERING AND SURVEYING, INC.
P.O. BOX 767 TERREBONNE, OR 97760
(541) 548-5833 www.APEandS.com