
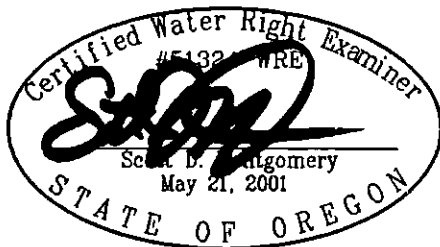


# CLAIM OF BENEFICIAL USE MAP

TO ADD PLACE OF USE FOR STORAGE  
PER APPLICATION R-35564  
OREGON DEPARTMENT OF STATE LANDS


SE 1/4 SECTION 13, TOWNSHIP 28 SOUTH, RANGE 35 EAST, W.M.  
TAX LOT: 100, HARNEY COUNTY, OREGON

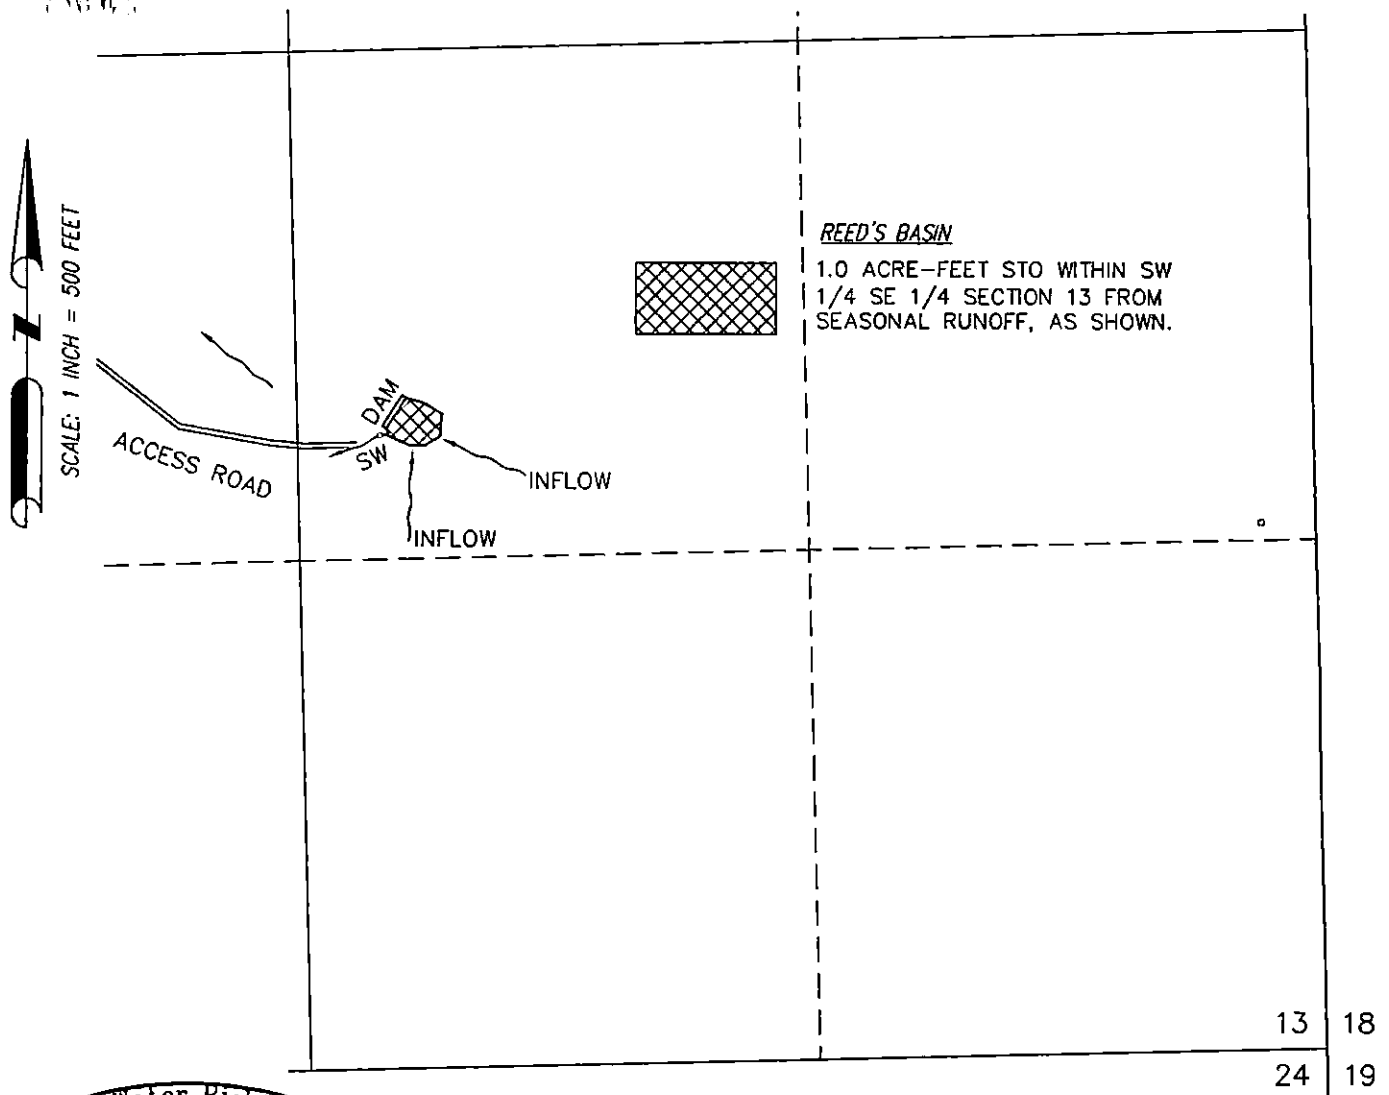


POD AT CENTER OF DAM IS LOCATED 1700'  
N & 250' E FROM 1/4 CORNER COMMON  
TO SECTIONS 13 & 24.

THIS MAP IS FOR THE PURPOSE OF LOCATING A WATER RIGHT ONLY AND HAS NO  
INTENT TO PROVIDE LEGAL DIMENSIONS OR THE LOCATION OF PROPERTY LINES.

PREPARED FOR:

OREGON DEPARTMENT OF STATE LANDS  
775 SUMMER STREET NE #100  
SALEM, OR 97301

PREPARED BY:



ALL POINTS ENGINEERING AND SURVEYING, INC.  
P.O. BOX 767 TERREBONNE, OR 97760  
(541) 548-5833 [www.APEandS.com](http://www.APEandS.com)