


CLAIM OF BENEFICIAL USE MAP

TO ADD PLACE OF USE FOR STORAGE
PER APPLICATION R-59624
OREGON DEPARTMENT OF STATE LANDS

SW 1/4 SECTION 15, TOWNSHIP 28 SOUTH, RANGE 35 EAST, W.M.
TAX LOT: 100, HARNEY COUNTY, OREGON

OCT 23 2025

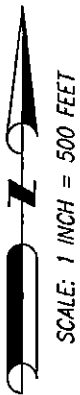

JENKINS #2


1.0 ACRE-FEET STO WITHIN SW
1/4 SW 1/4 SECTION 15 FROM
SEASONAL RUNOFF, AS SHOWN.

ACCESS ROAD



INFLOW

15 14
22 23

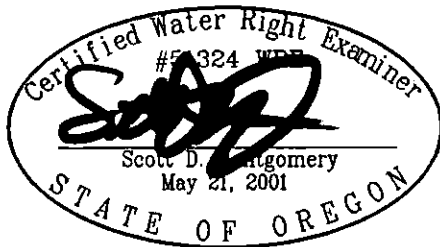

RENEWAL DATE: 12/31/2026

POD AT CENTER OF DAM IS LOCATED 330'
N & 340' E FROM SW CORNER SECTION 14.

THIS MAP IS FOR THE PURPOSE OF LOCATING A WATER RIGHT ONLY AND HAS NO
INTENT TO PROVIDE LEGAL DIMENSIONS OR THE LOCATION OF PROPERTY LINES.

PREPARED FOR:

OREGON DEPARTMENT OF STATE LANDS
775 SUMMER STREET NE #100
SALEM, OR 97301

PREPARED BY:



ALL POINTS ENGINEERING AND SURVEYING, INC.
P.O. BOX 767 TERREBONNE, OR 97760
(541) 548-5833 www.APEandS.com