
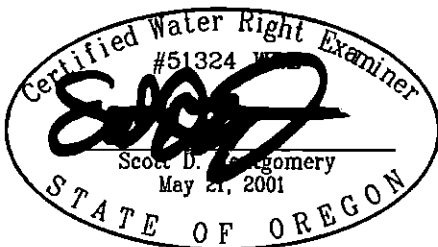


CLAIM OF BENEFICIAL USE MAP

TO ADD PLACE OF USE FOR STORAGE
PER APPLICATION R-59628
OREGON DEPARTMENT OF STATE LANDS

OCT 23 2025

NE 1/4 SECTION 20, TOWNSHIP 28 SOUTH, RANGE 36 EAST, W.M.
TAX LOT: 501, HARNEY COUNTY, OREGON

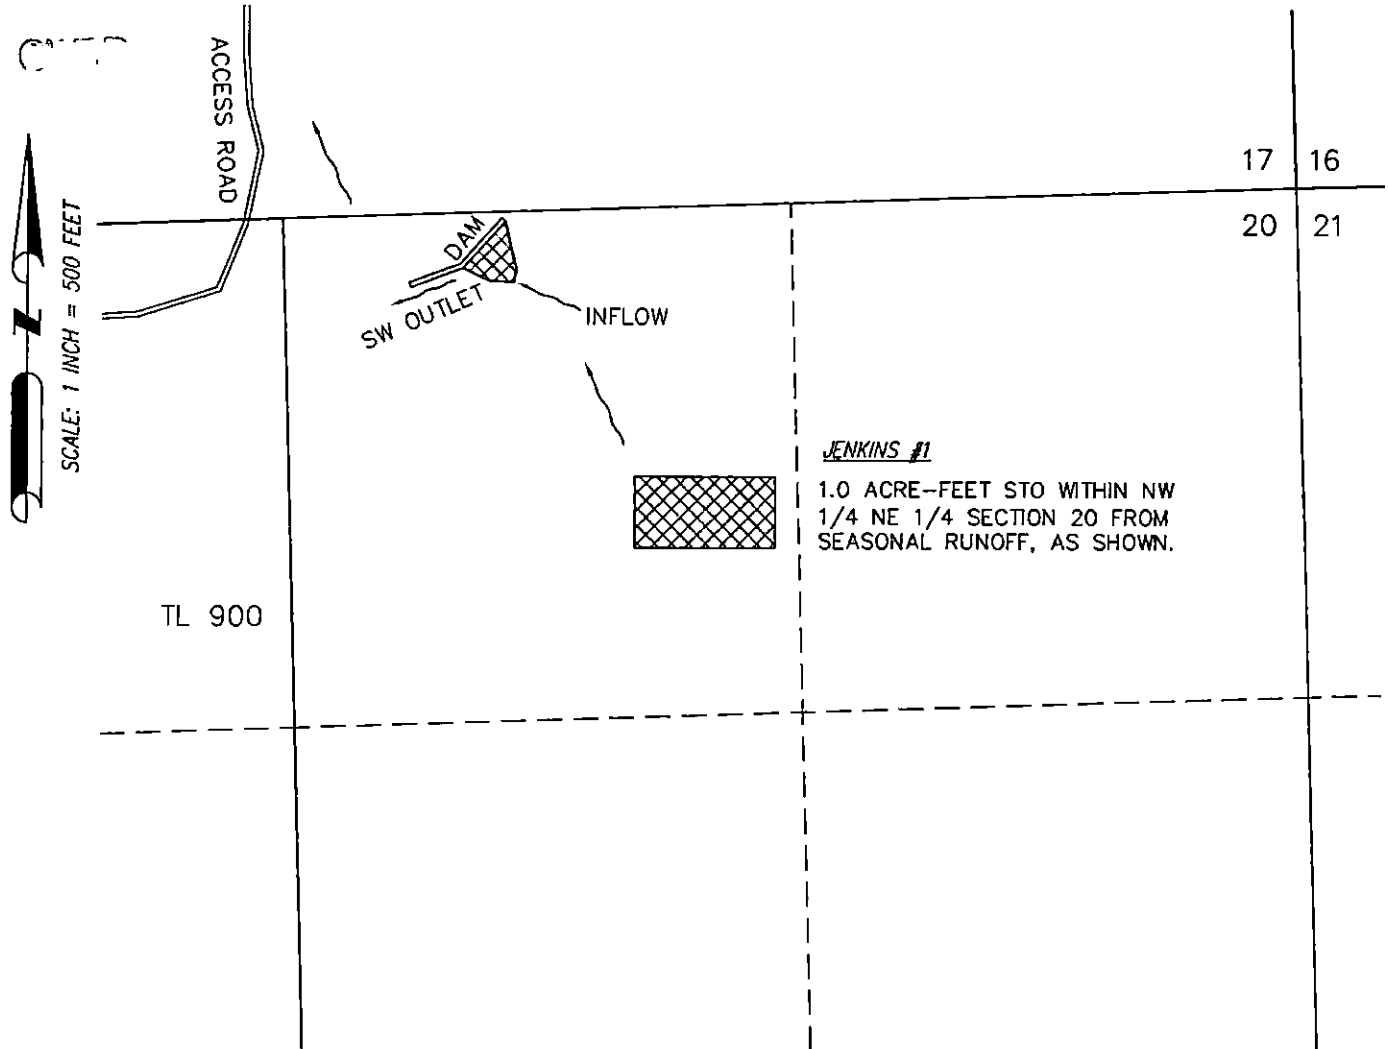

RENEWAL DATE: 12/31/2026

POD AT CENTER OF DAM IS LOCATED 75' S
& 510' E FROM 1/4 CORNER COMMON TO
SECTIONS 17 & 20.

THIS MAP IS FOR THE PURPOSE OF LOCATING A WATER RIGHT ONLY AND HAS NO
INTENT TO PROVIDE LEGAL DIMENSIONS OR THE LOCATION OF PROPERTY LINES.

PREPARED FOR:

OREGON DEPARTMENT OF STATE LANDS
775 SUMMER STREET NE #100
SALEM, OR 97301

PREPARED BY:



ALL POINTS ENGINEERING AND SURVEYING, INC.
P.O. BOX 767 TERREBONNE, OR 97760
(541) 548-5833
www.APEandS.com