



CLAIM OF BENEFICIAL USE MAP

TO ADD A POINT OF DIVERSION & PLACE OF USE
PER APPLICATION S-35393


OCT 23 2025

OREGON DEPARTMENT OF STATE LANDS

SE 1/4 SECTION 26, TOWNSHIP 28 SOUTH, RANGE 36 EAST, W.M.
TAX LOT: 1101, HARNEY COUNTY, OREGON

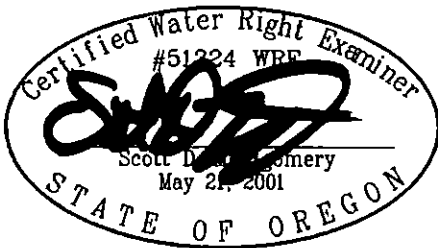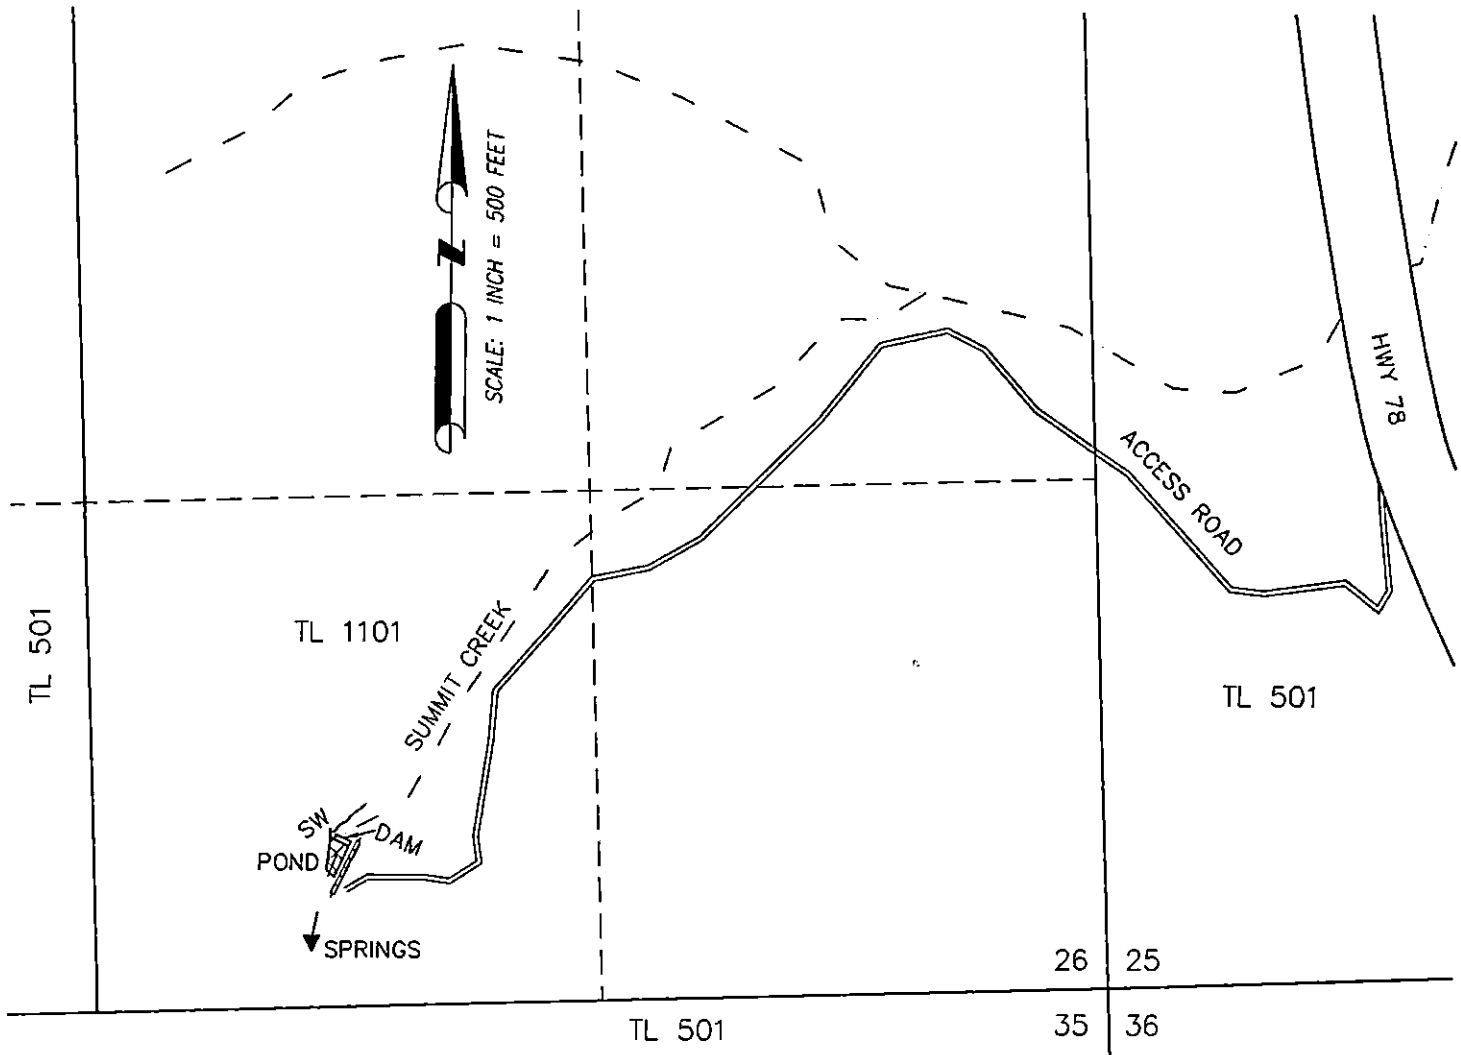


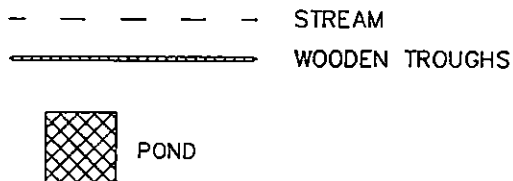

DAM
POD AT CENTER OF DAM LOCATED
435' N & 650' E FROM 1/4 CORNER
COMMON TO SECTIONS 26 & 35.

THIS MAP IS FOR THE PURPOSE OF LOCATING A WATER RIGHT ONLY AND HAS NO
INTENT TO PROVIDE LEGAL DIMENSIONS OR THE LOCATION OF PROPERTY LINES.

PREPARED FOR:

OREGON DEPARTMENT OF STATE LANDS
775 SUMMER STREET NE #100
SALEM, OR 97301

PREPARED BY:



ALL POINTS ENGINEERING AND SURVEYING, INC.
P.O. BOX 767 TERREBONNE, OR 97760
(541) 548-5833
www.APEandS.com