
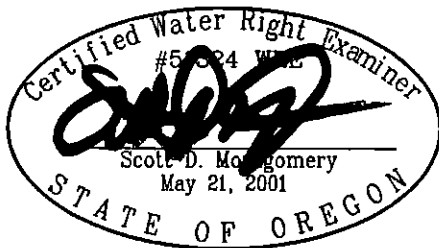
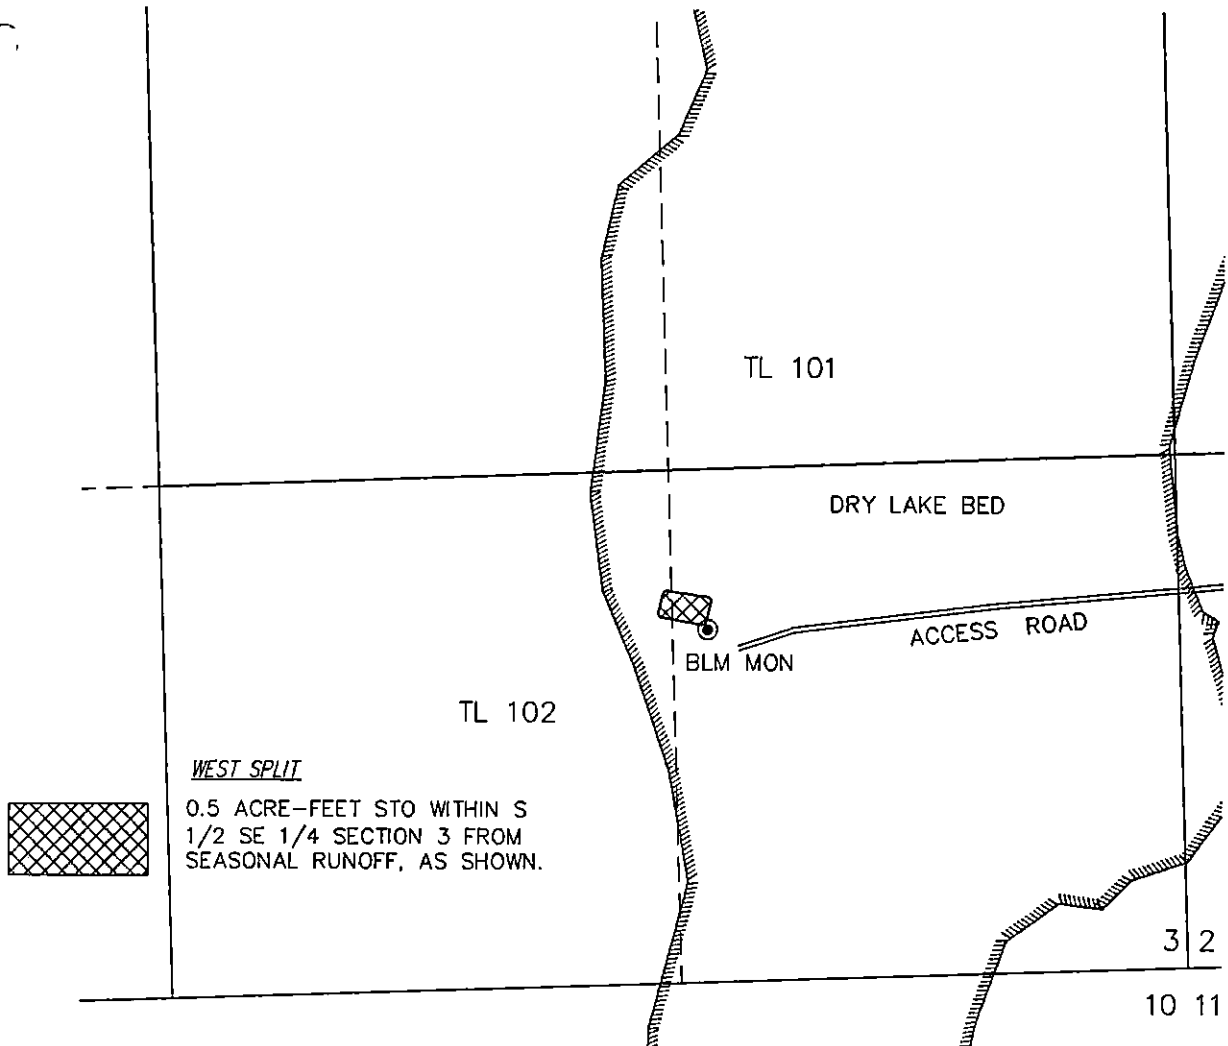


CLAIM OF BENEFICIAL USE MAP

TO ADD PLACE OF USE FOR STORAGE
PER APPLICATION R-67883
OREGON DEPARTMENT OF STATE LANDS


SE 1/4 SECTION 3, TOWNSHIP 29 SOUTH, RANGE 38 EAST, W.M.
TAX LOT: 102, MALHEUR COUNTY, OREGON

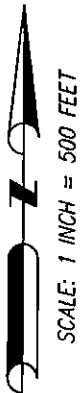


POD AT CENTER OF PIT IS LOCATED 970' N
& 1300' W FROM SE CORNER OF SECTION 3.

THIS MAP IS FOR THE PURPOSE OF LOCATING A WATER RIGHT ONLY AND HAS NO
INTENT TO PROVIDE LEGAL DIMENSIONS OR THE LOCATION OF PROPERTY LINES.

PREPARED FOR:

OREGON DEPARTMENT OF STATE LANDS
775 SUMMER STREET NE #100
SALEM, OR 97301

PREPARED BY:



ALL POINTS ENGINEERING AND SURVEYING, INC.
P.O. BOX 767 TERREBONNE, OR 97760
(541) 548-5833
www.APEandS.com