


CLAIM OF BENEFICIAL USE MAP

TO ADD PLACE OF USE FOR STORAGE
PER APPLICATION R-67068



SE 1/4 SECTION 17, TOWNSHIP 27 SOUTH, RANGE 37 EAST, W.M.
TAX LOT: 101, MALHEUR COUNTY, OREGON

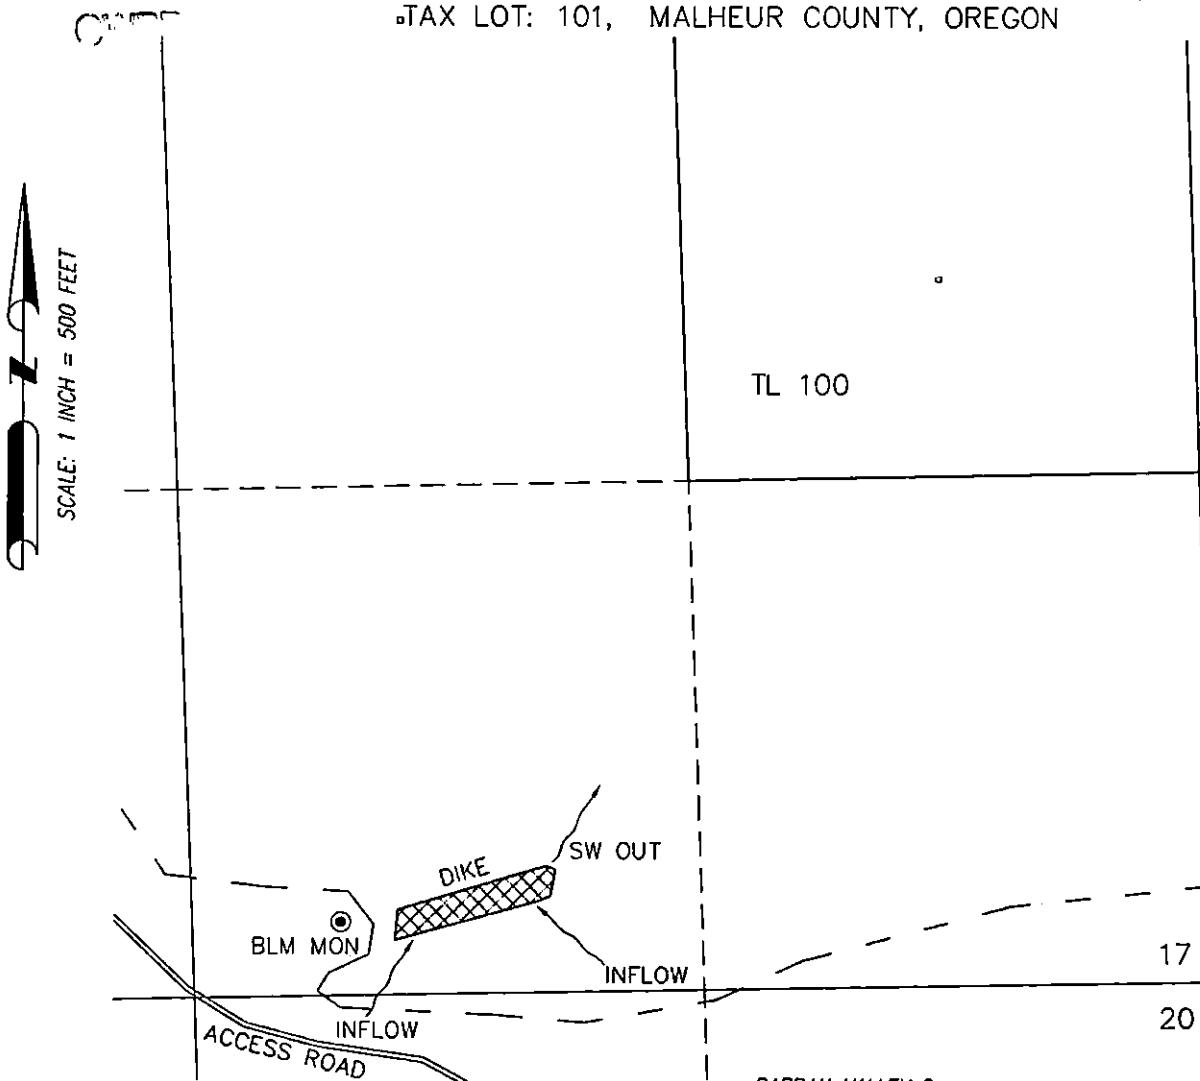

1.62 ACRE-FEET STO WITHIN SW
1/4 SE 1/4 SECTION 17 FROM
SEASONAL RUNOFF, AS SHOWN.

POD AT CENTER OF PIT IS LOCATED 240' N
& 720' E FROM 1/4 CORNER COMMON TO
SECTIONS 17 & 20.

THIS MAP IS FOR THE PURPOSE OF LOCATING A WATER RIGHT ONLY AND HAS NO
INTENT TO PROVIDE LEGAL DIMENSIONS OR THE LOCATION OF PROPERTY LINES.

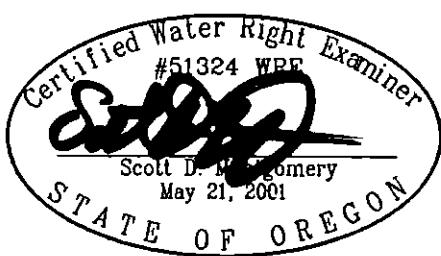


PREPARED FOR:

OREGON DEPARTMENT OF STATE LANDS
775 SUMMER STREET NE #100
SALEM, OR 97301

PREPARED BY:



ALL POINTS ENGINEERING AND SURVEYING, INC.
P.O. BOX 767 TERREBONNE, OR 97760
(541) 548-5833 www.APEandS.com