

CLAIM OF BENEFICIAL USE MAP



TO ADD PLACE OF USE FOR STORAGE
PER APPLICATION R-67054

OREGON DEPARTMENT OF STATE LANDS

NE 1/4 SECTION 19, TOWNSHIP 27 SOUTH, RANGE 37 EAST, W.M.
TAX LOT: 101, MALHEUR COUNTY, OREGON

2021 23 2025


0.0000°

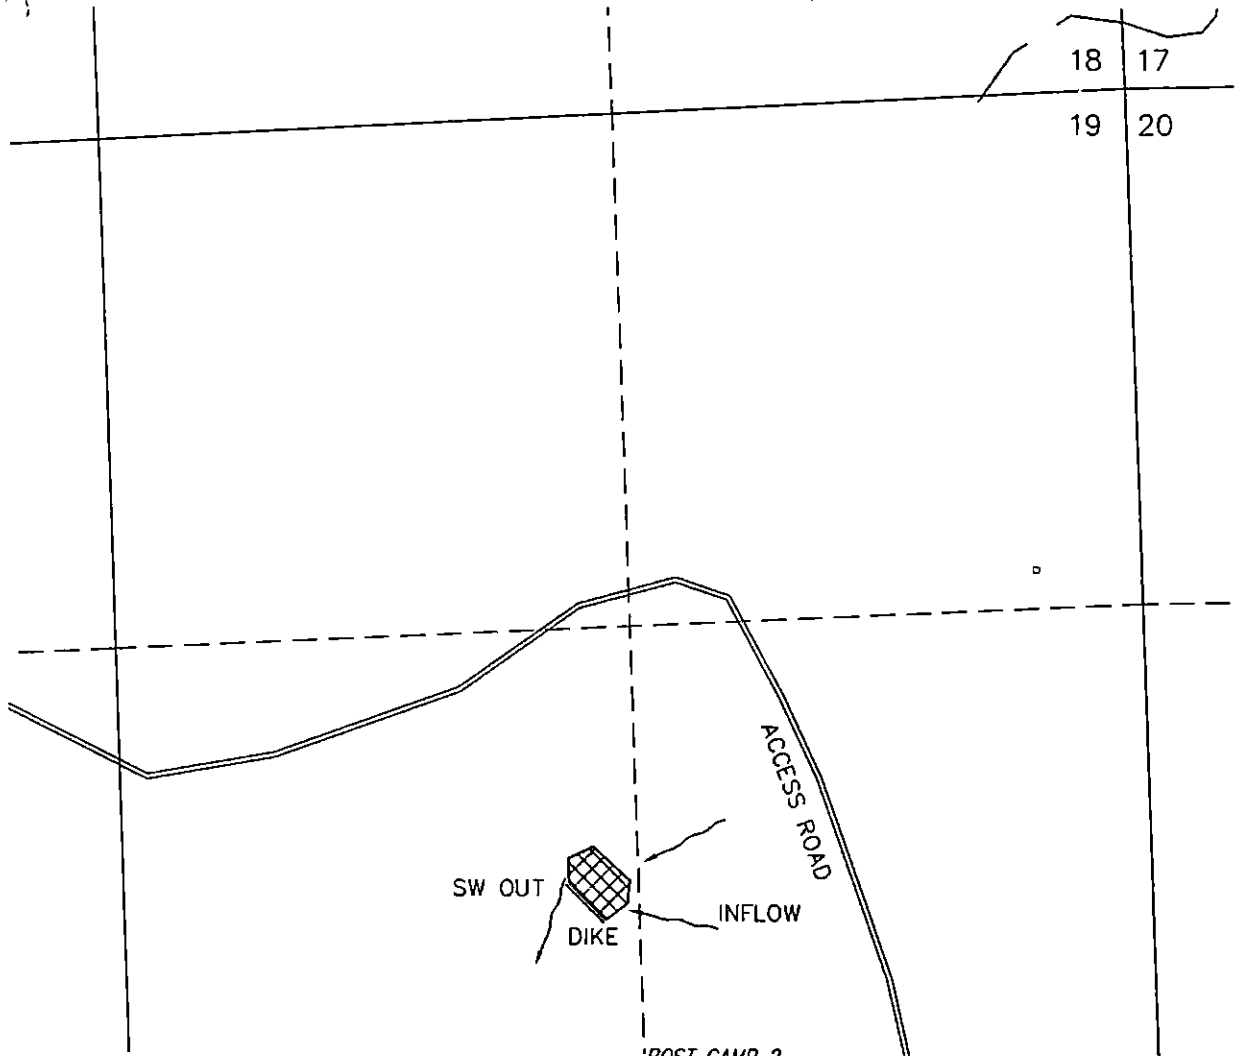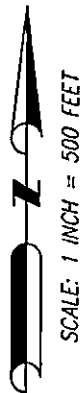

0.5 ACRE-FEET STO WITHIN SE
1/4 NW 1/4 SECTION 19 FROM
SEASONAL RUNOFF, AS SHOWN.

POD AT CENTER OF PIT IS LOCATED 1985' S &
1840' W FROM NE CORNER OF SECTION 19.

THIS MAP IS FOR THE PURPOSE OF LOCATING A WATER RIGHT ONLY AND HAS NO
INTENT TO PROVIDE LEGAL DIMENSIONS OR THE LOCATION OF PROPERTY LINES.

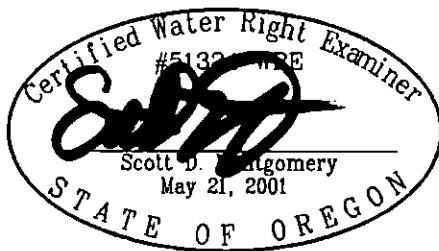

RENEWAL DATE: 12/31/2026

PREPARED FOR:

OREGON DEPARTMENT OF STATE LANDS
775 SUMMER STREET NE #100
SALEM, OR 97301

PREPARED BY:



ALL POINTS ENGINEERING AND SURVEYING, INC.
P.O. BOX 767 TERREBONNE, OR 97760
(541) 548-5833
www.APEandS.com