

CLAIM OF BENEFICIAL USE MAP



TO ADD PLACE OF USE FOR STORAGE
PER APPLICATION R-59166

RECEIVED

OCT 23 2025 NE 1/4 SECTION 4, TOWNSHIP 28 SOUTH, RANGE 37 EAST, W.M.
TAX LOT: 101, MALHEUR COUNTY, OREGON

CRAYON

T27S, R37E, W.M.

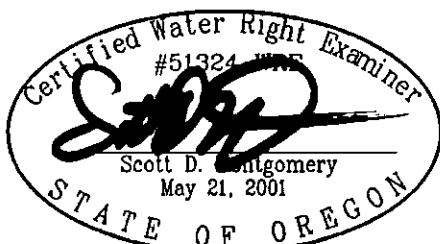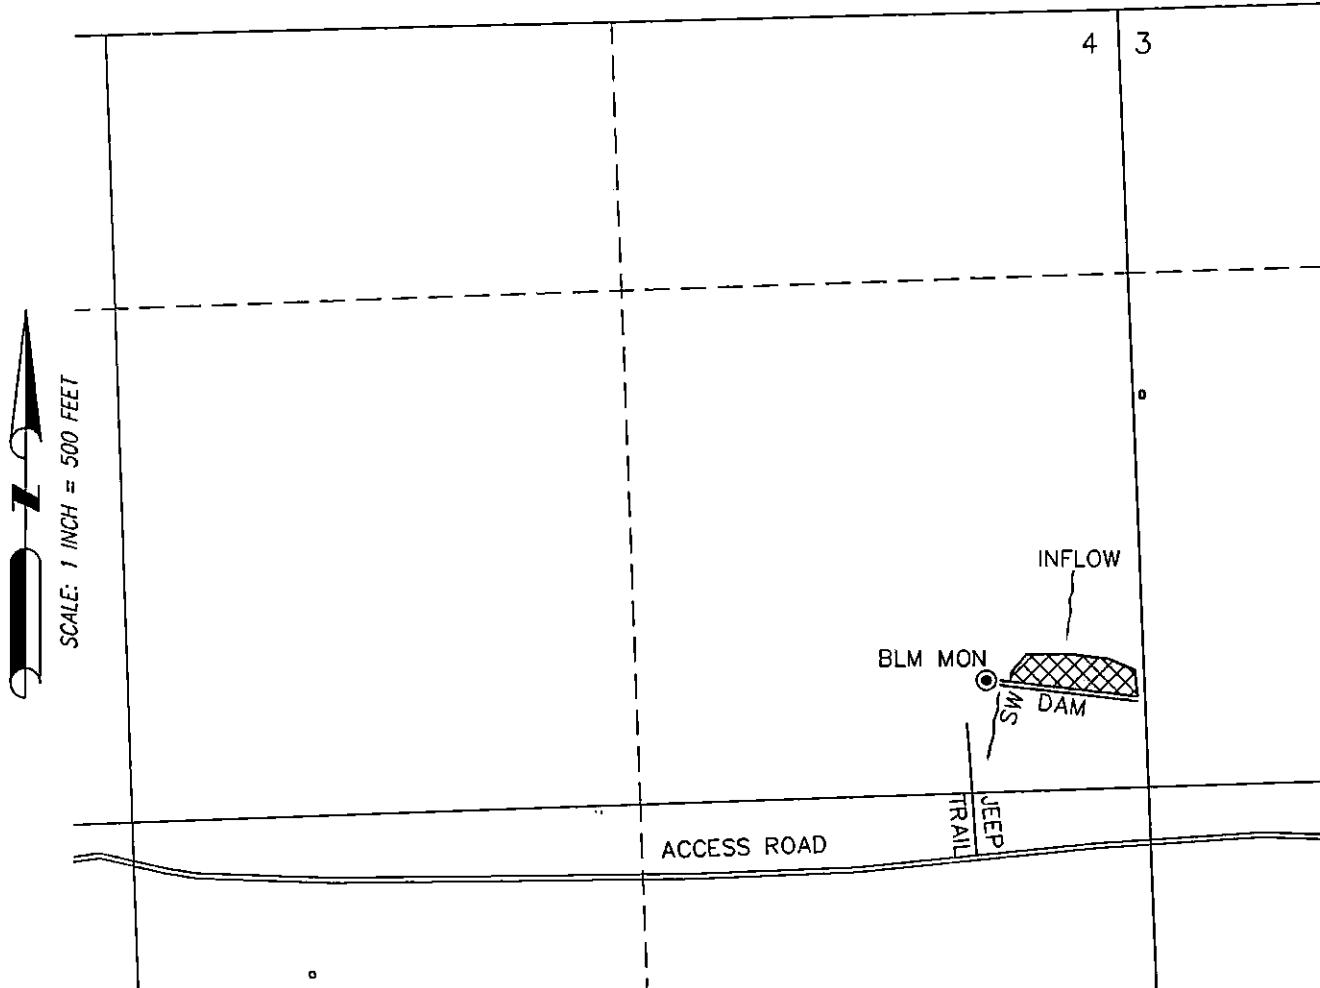


PREPARED FOR:

OREGON DEPARTMENT OF STATE LANDS
775 SUMMER STREET NE #100
SALEM, OR 97301

PREPARED BY:



ALL POINTS ENGINEERING AND SURVEYING, INC.
P.O. BOX 767 TERREBONNE, OR 97760
(541) 548-5833 www.APEandS.com

