

CLAIM OF BENEFICIAL USE MAP

TO ADD PLACE OF USE FOR STORAGE

PER APPLICATION R-67865

OREGON DEPARTMENT OF STATE LANDS



NE 1/4 SECTION 6, TOWNSHIP 28 SOUTH, RANGE 37 EAST, W.M.

TAX LOT: 101, MALHEUR COUNTY, OREGON

RECORDED:
OCT 23 2025

OWNER:

T27S, R37E, W.M.

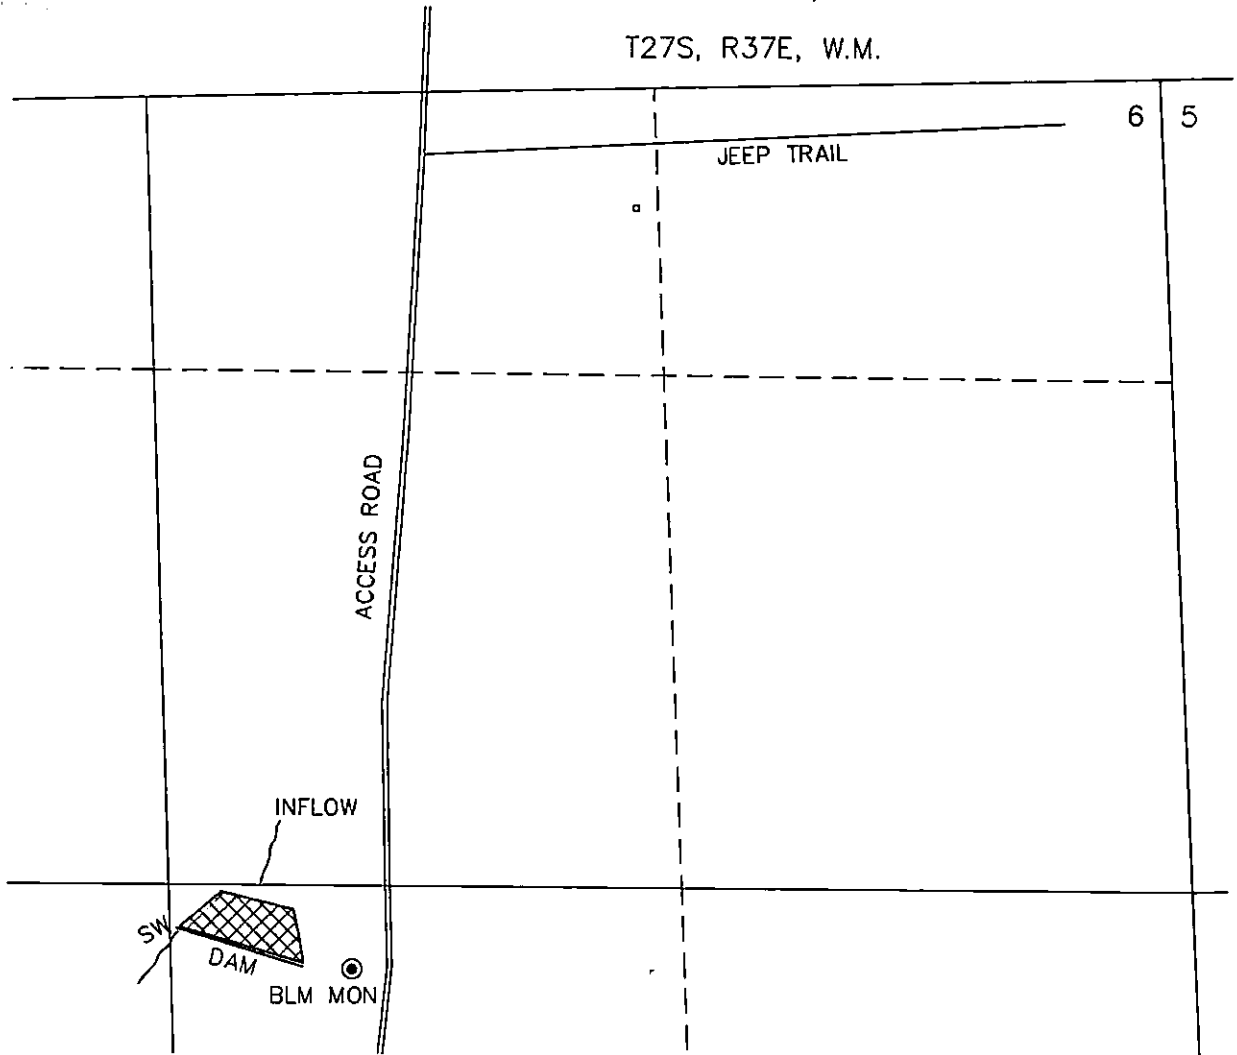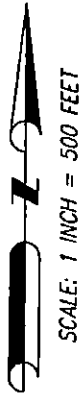


WAGON TRACK



1.0 ACRE-FEET STO WITHIN SW
1/4 NE 1/4 SECTION 6 FROM
SEASONAL RUNOFF, AS SHOWN.

POD AT CENTER OF DAM IS LOCATED 160' S & 2475'
W FROM 1/4 CORNER COMMON TO SECTIONS 5 & 6.

THIS MAP IS FOR THE PURPOSE OF LOCATING A WATER RIGHT ONLY AND HAS NO
INTENT TO PROVIDE LEGAL DIMENSIONS OR THE LOCATION OF PROPERTY LINES.

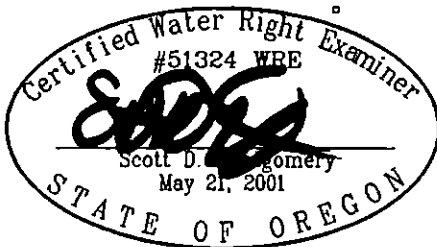

RENEWAL DATE: 12/31/2026

PREPARED FOR:

OREGON DEPARTMENT OF STATE LANDS
775 SUMMER STREET NE #100
SALEM, OR 97301

PREPARED BY:



ALL POINTS ENGINEERING AND SURVEYING, INC.
P.O. BOX 767 TERREBONNE, OR 97760
(541) 548-5833
www.APEandS.com