


Township 36S, Range 3W.

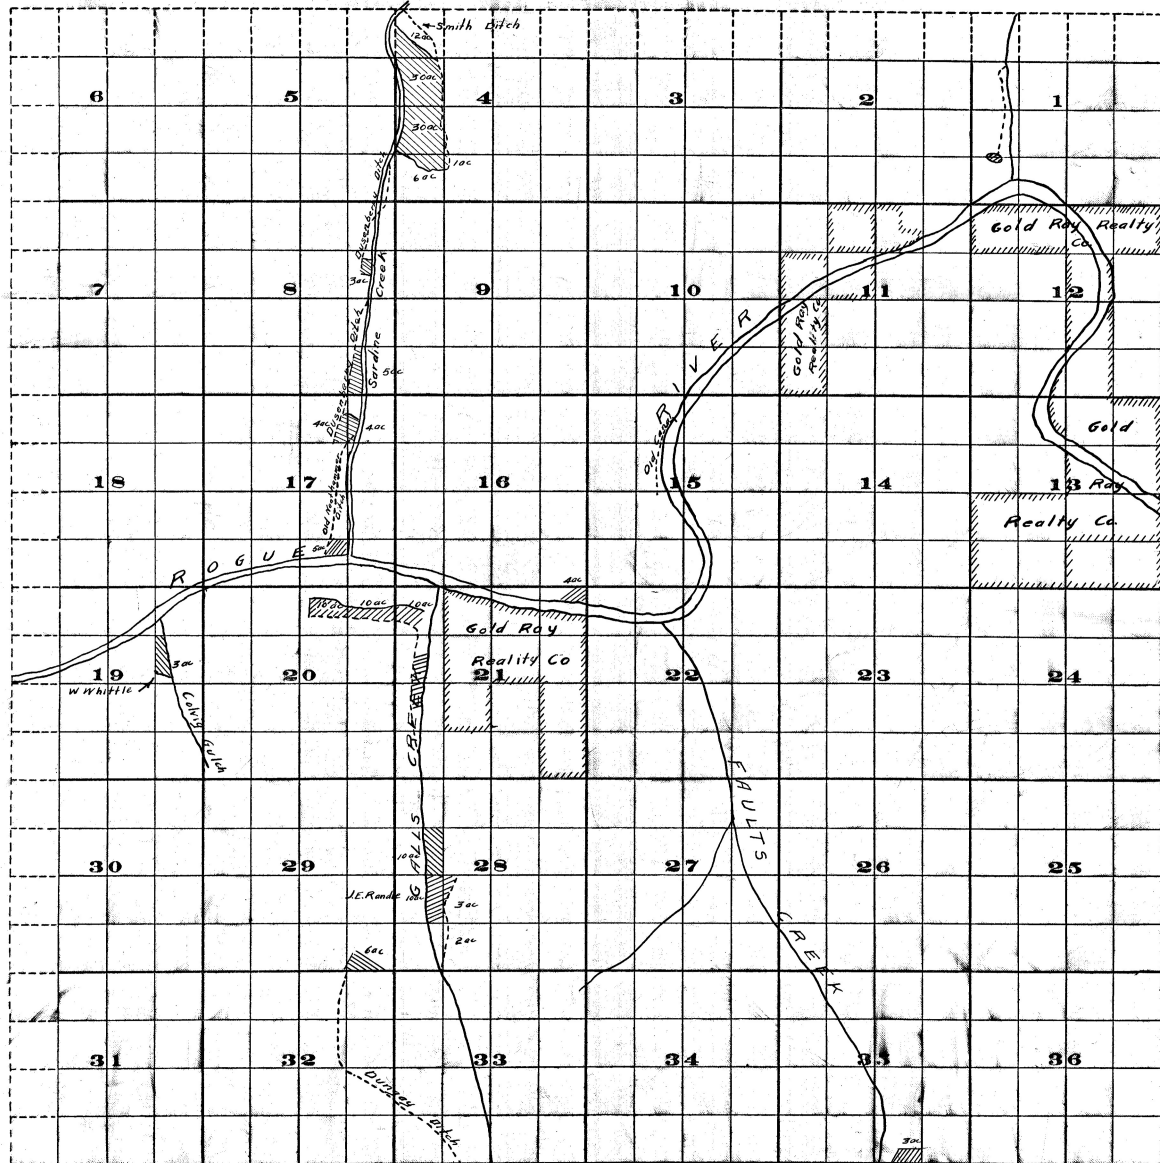

Survey by H.K. Donnelly 1910
Scale of Feet.

FROM OFFICE OF THE STATE ENGINEER, MALEM, OREGON

Examined Sept. 18, 1911.

Adjudication
Rogue River and Tributaries
John H. Lewis State Engr.