

Received

OCT 23 2025

OWRD

TOWNSHIP 2 SOUTH RANGE 44 EAST

July 3, 2025


CLAIM OF BENEFICIAL USE  
FOR TRANSFER OF A PLACE OF  
USE AND AN ADDITIONAL POINT  
OF DIVERSION

FOR  
BILL ABLES  
BY

BAGETT, GRIFFITH AND BLACKMAN  
2006 ADAMS AVE  
LA GRANDE, OREGON 97850

SCALE: 1"=400'

LEGEND

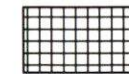

Place of use for Certificate 3041  
(Priority Date 1885) to be transferred  
and to receive right from Certificate  
3568 (Priority Date Dec. 6, 1915)



Place of use for Certificate 3568  
(Priority Date Dec. 6, 1915) to be  
transferred and to receive right from  
Certificate 3041 (Priority Date 1885)



Acreage of Certificate 3041 to be  
transferred, and to receive right from  
Certificate 3568



Acreage of Certificate 3568 to be  
transferred, and to receive right from  
Certificate 3041



Point of Diversion



Irrigation Riser




Mainline

Received

OCT 09 2025

OWRD

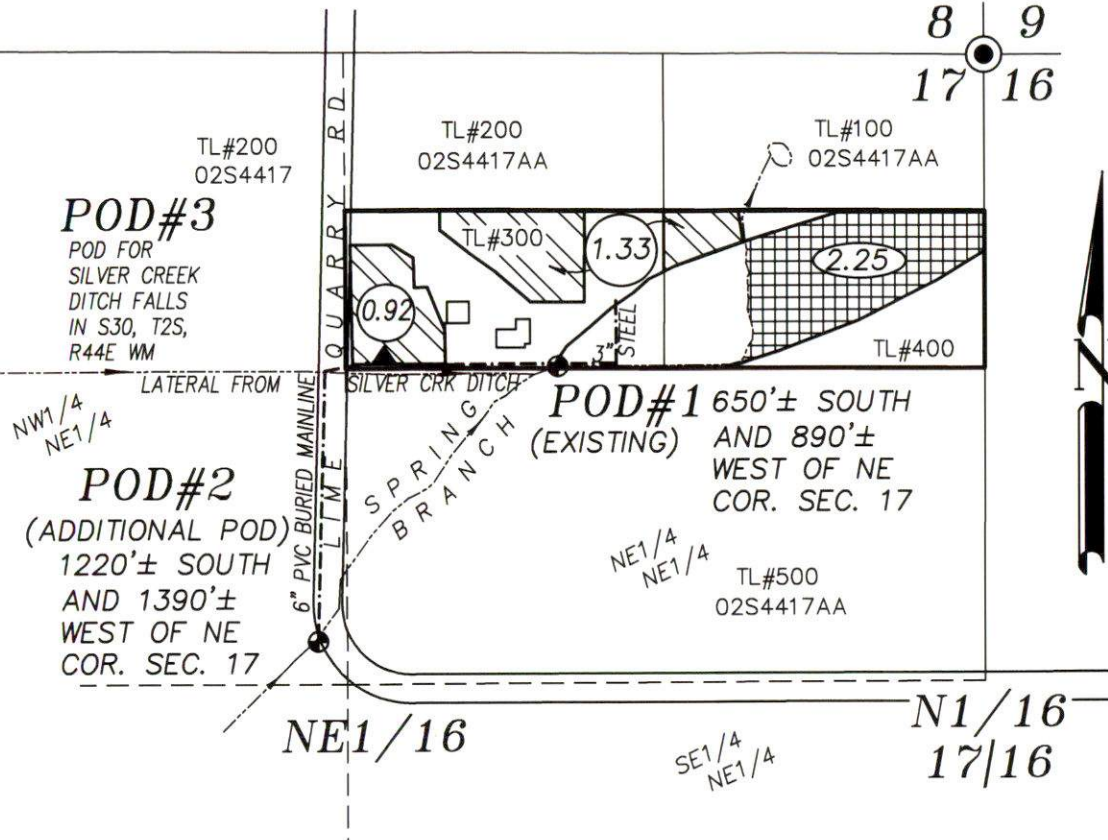

Renews: June 30, 2027

NOTE: The preparation of this map was for the purpose of identifying the location of proposed water rights and is not intended to provide dimensions or location of property ownership lines. Location information hereon was furnished by the applicant.

APPLICATION NO T-14030