



CLAIM OF BENEFICIAL USE MAP

TO ADD PLACE OF USE FOR STORAGE
PER APPLICATION R-36380
OREGON DEPARTMENT OF STATE LANDS

NE 1/4 SECTION 19, TOWNSHIP 27 SOUTH, RANGE 25 EAST, W.M.
TAX LOT: 200, HARNEY COUNTY, OREGON

18 17

19 20

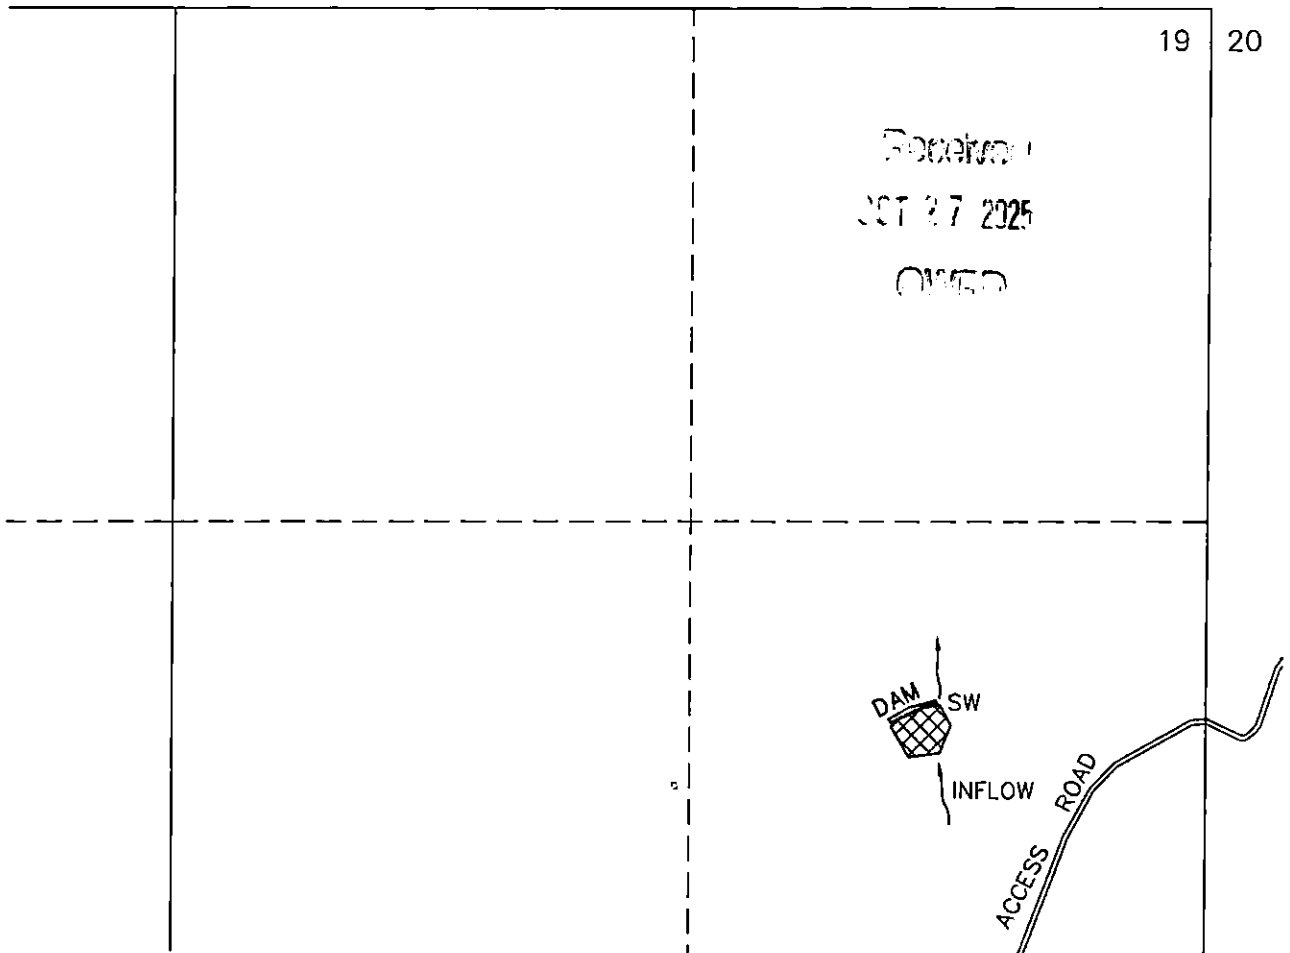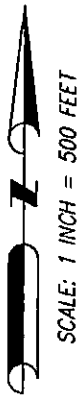


SETTLEMENT



1.2 ACRE-FEET STO WITHIN SE
1/4 NE 1/4 SECTION 19 FROM
SEASONAL RUNOFF, AS SHOWN.

POD AT CENTER OF DAM IS LOCATED 1820' S
& 770' W FROM NE CORNER OF SECTION 19.

THIS MAP IS FOR THE PURPOSE OF LOCATING A WATER RIGHT ONLY AND HAS NO
INTENT TO PROVIDE LEGAL DIMENSIONS OR THE LOCATION OF PROPERTY LINES.

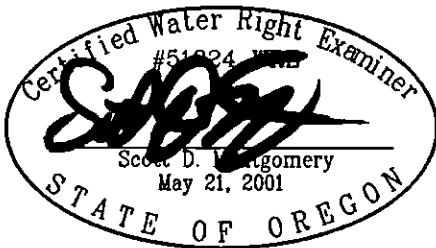

RENEWAL DATE: 12/31/2026

PREPARED FOR:

OREGON DEPARTMENT OF STATE LANDS
775 SUMMER STREET NE #100
SALEM, OR 97301

PREPARED BY:



ALL POINTS ENGINEERING AND SURVEYING, INC.
P.O. BOX 767 TERREBONNE, OR 97760
(541) 548-5833
www.APEandS.com