

# CLAIM OF BENEFICIAL USE MAP

TO ADD PLACE OF USE FOR STORAGE

PER APPLICATION R-36304

OREGON DEPARTMENT OF STATE LANDS


Received

NE 1/4 SECTION 4, TOWNSHIP 28 SOUTH, RANGE 24 EAST, W.M.  
TAX LOT: 400, HARNEY COUNTY, OREGON

OCT 27 2025


31 32

4 3

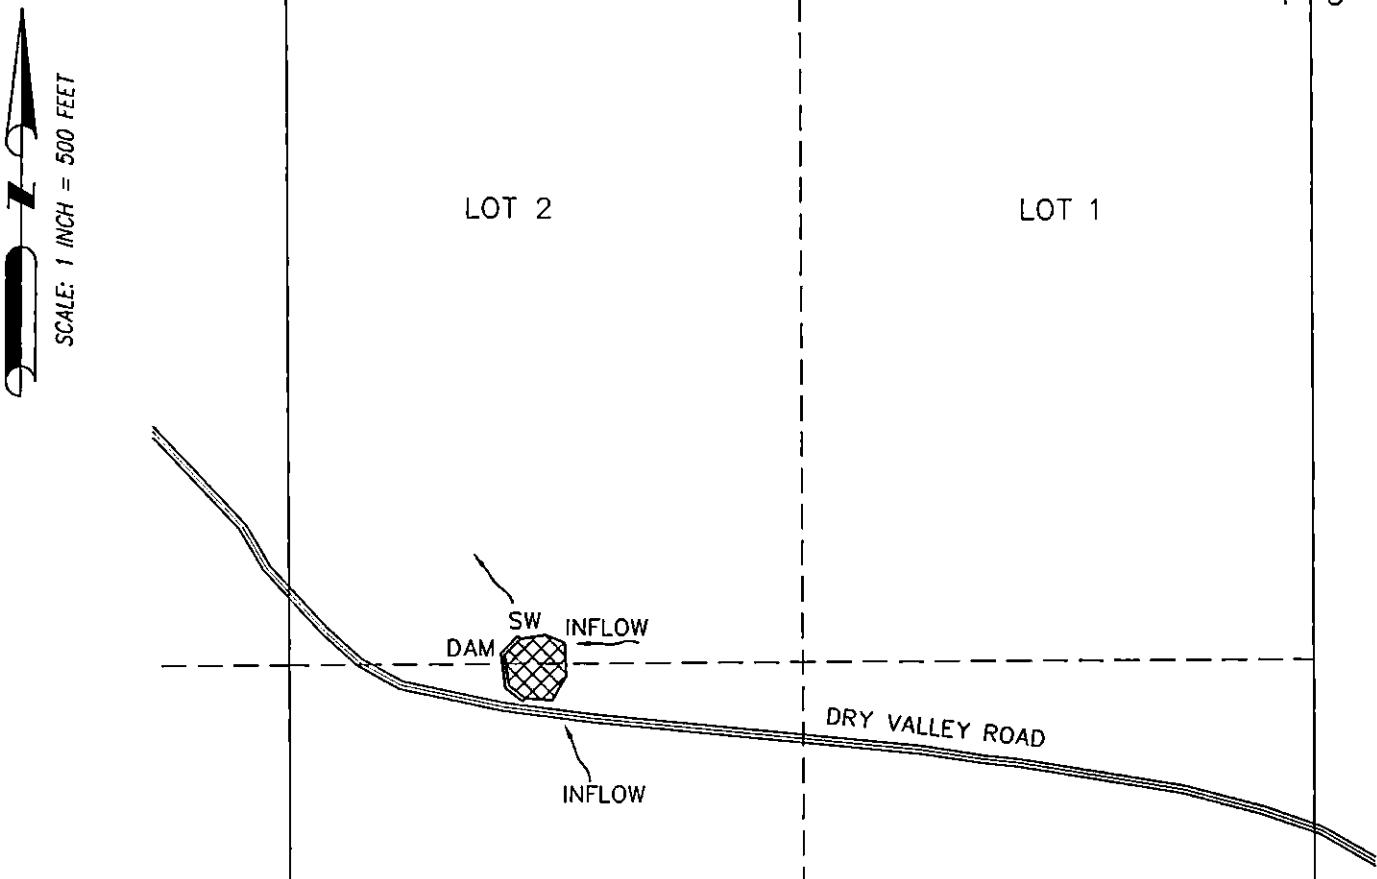


SCHRODER #2

2.0 ACRE-FEET STO WITHIN W  
1/2 NE 1/4 SECTION 4 FROM  
SEASONAL RUNOFF, AS SHOWN.

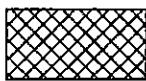

POD AT CENTER OF DAM IS LOCATED 1765' S  
& 2115' W FROM NE CORNER OF SECTION 4.

THIS MAP IS FOR THE PURPOSE OF LOCATING A WATER RIGHT ONLY AND HAS NO  
INTENT TO PROVIDE LEGAL DIMENSIONS OR THE LOCATION OF PROPERTY LINES.

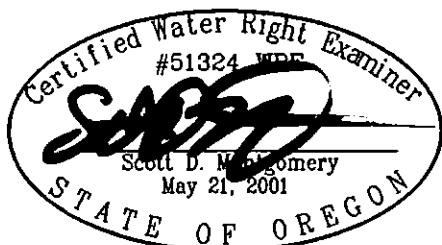

RENEWAL DATE: 12/31/2026

PREPARED FOR:

OREGON DEPARTMENT OF STATE LANDS  
775 SUMMER STREET NE #100  
SALEM, OR 97301

PREPARED BY:



ALL POINTS ENGINEERING AND SURVEYING, INC.  
P.O. BOX 767 TERREBONNE, OR 97760  
(541) 548-5833 [www.APEandS.com](http://www.APEandS.com)