



CLAIM OF BENEFICIAL USE MAP

TO ADD PLACE OF USE FOR STORAGE

PER APPLICATION R-36331

OREGON DEPARTMENT OF STATE LANDS

SE 1/4 SECTION 28, TOWNSHIP 27 SOUTH, RANGE 24 EAST, W.M.
TAX LOT: 100, HARNEY COUNTY, OREGON

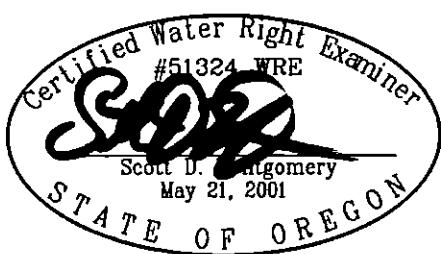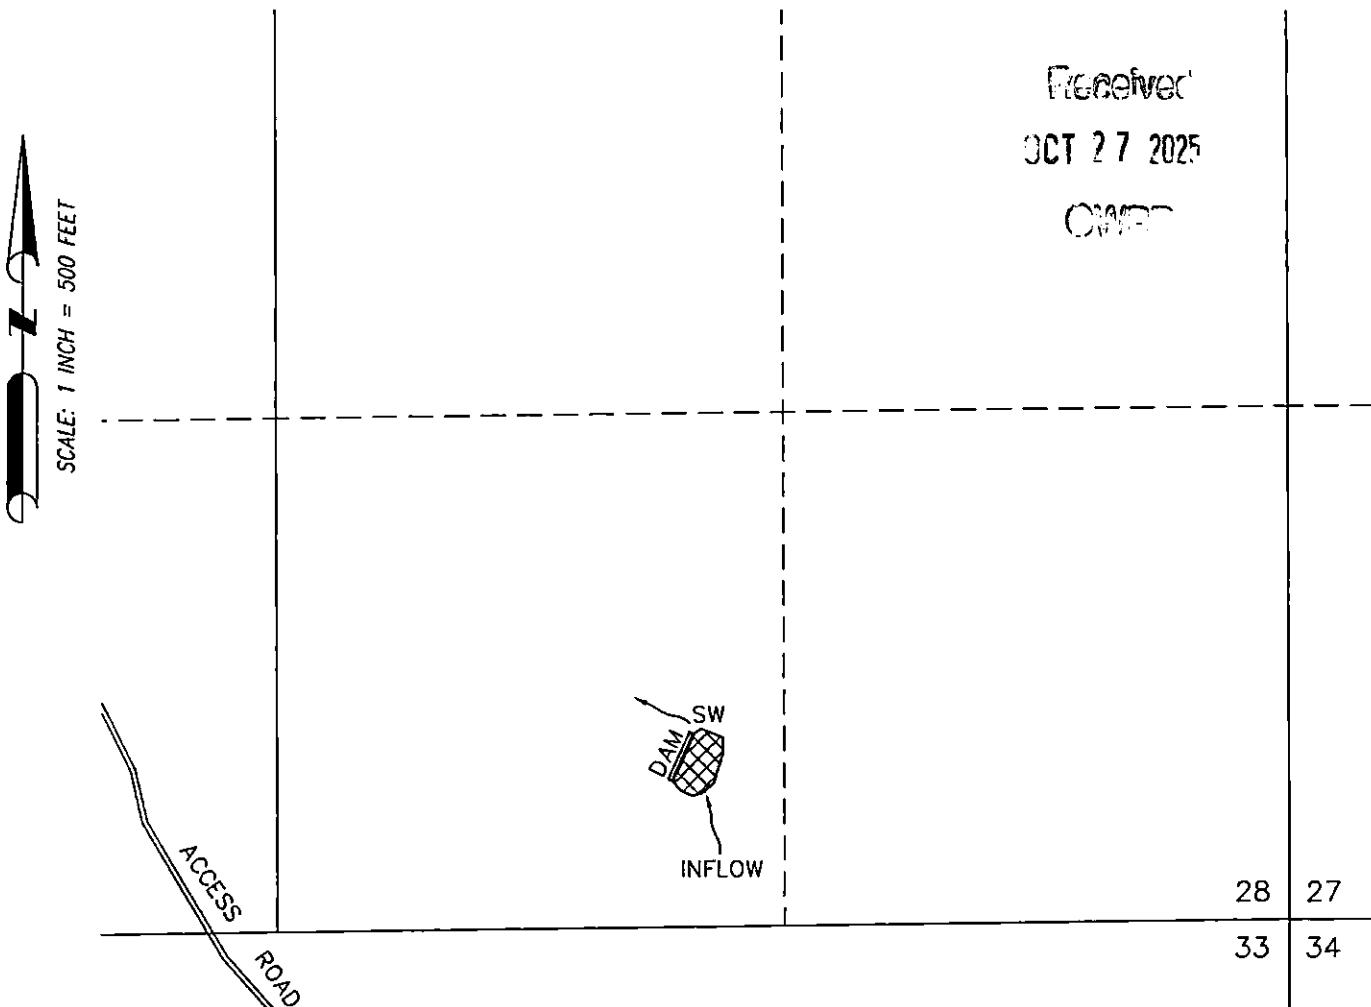

RENEWAL DATE: 12/31/2026

PREPARED FOR:

OREGON DEPARTMENT OF STATE LANDS
775 SUMMER STREET NE #100
SALEM, OR 97301

PREPARED BY:



ALL POINTS ENGINEERING AND SURVEYING, INC.
P.O. BOX 767 TERREBONNE, OR 97760
(541) 548-5833 www.APEandS.com

PREPARED FOR:	PREPARED BY:
OREGON DEPARTMENT OF STATE LANDS 775 SUMMER STREET NE #100 SALEM, OR 97301	ALL POINTS ENGINEERING AND SURVEYING, INC. P.O. BOX 767 TERREBONNE, OR 97760 (541) 548-5833 www.APEandS.com

