
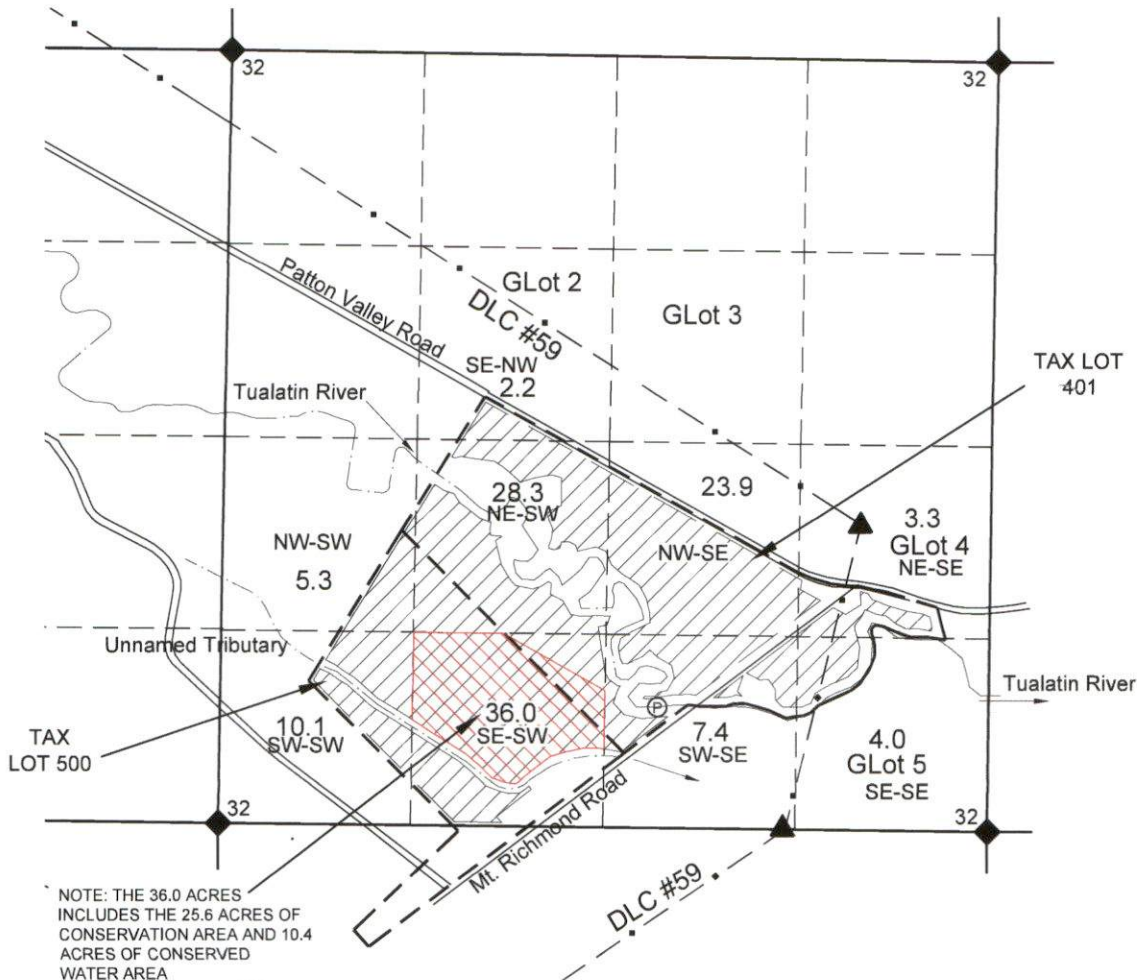


MAP FOR

Claim of Beneficial Use

S32, T1S, R4W, WASHINGTON COUNTY

CW-122 (Allocation of Conserved Water)

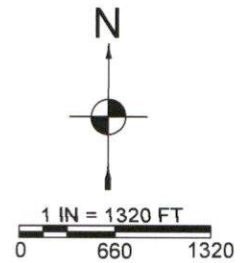

NOTE: THE 36.0 ACRES INCLUDES THE 25.6 ACRES OF CONSERVATION AREA AND 10.4 ACRES OF CONSERVED WATER AREA

THE POD IS A MOBILE POD AND IS 850' NORTH AND 2660' WEST FROM THE SE CORNER S32.
THE METER IS 65 FEET S40°E FROM THE POD AND IS ON THE EAST SIDE OF A SHED.

NOTES:

- THIS MAP IS NOT INTENDED TO PROVIDE LEGAL DIMENSIONS OR LOCATIONS OF PROPERTY OWNERSHIP LINES.
- THE SECTION, DLC, AND PROPERTY LINES ARE FROM A SCALED TAX ASSESSOR MAP.
- GOVERNMENT LOTS (GLot) ARE FROM GENERAL LAND OFFICE RECORDS.
- WATER CONVEYANCE PIPELINES ARE NOT SHOWN; ALL ARE WITHIN THE PROPERTY OWNERSHIP.
- THERE ARE TWO FARM SHEDS IN THE VICINITY OF THE POD, THE POD IS NORTHERLY OF THE WEST SHED, AND THE METER IS ON THE EAST SIDE OF THE EAST SHED. THE PUMP AND FISH SCREEN ARE MOBILE; AND THEREFORE THEIR POSITION WILL CHANGE.

LEGEND

- ▲ DONATION LAND CLAIM (DLC) CORNER
- ◆ SECTION OR QUARTER CORNER
- ⊕ PROPOSED POINT OF DIVERSION (POD)

- QUARTER-QUARTER LINE
- DLC LINE
- TAX LOT LINE
- SECTION LINE

- CONSERVED WATER AREA
- CONSERVATION AREA - 25.6 ACRES



EXPIRES 06/30/2026

Received

OCT 24 2025

OWRD

MAP BY:
ASPEN RURAL LAND CONSULTING
ERIC URSTADT, PE, PLs
971-250-1520
SEP 2025
WVL-Patton6D