


Groundwater Application - Wenz

AMENDED 10/29/2025

0 660 1,320 2,640 Feet

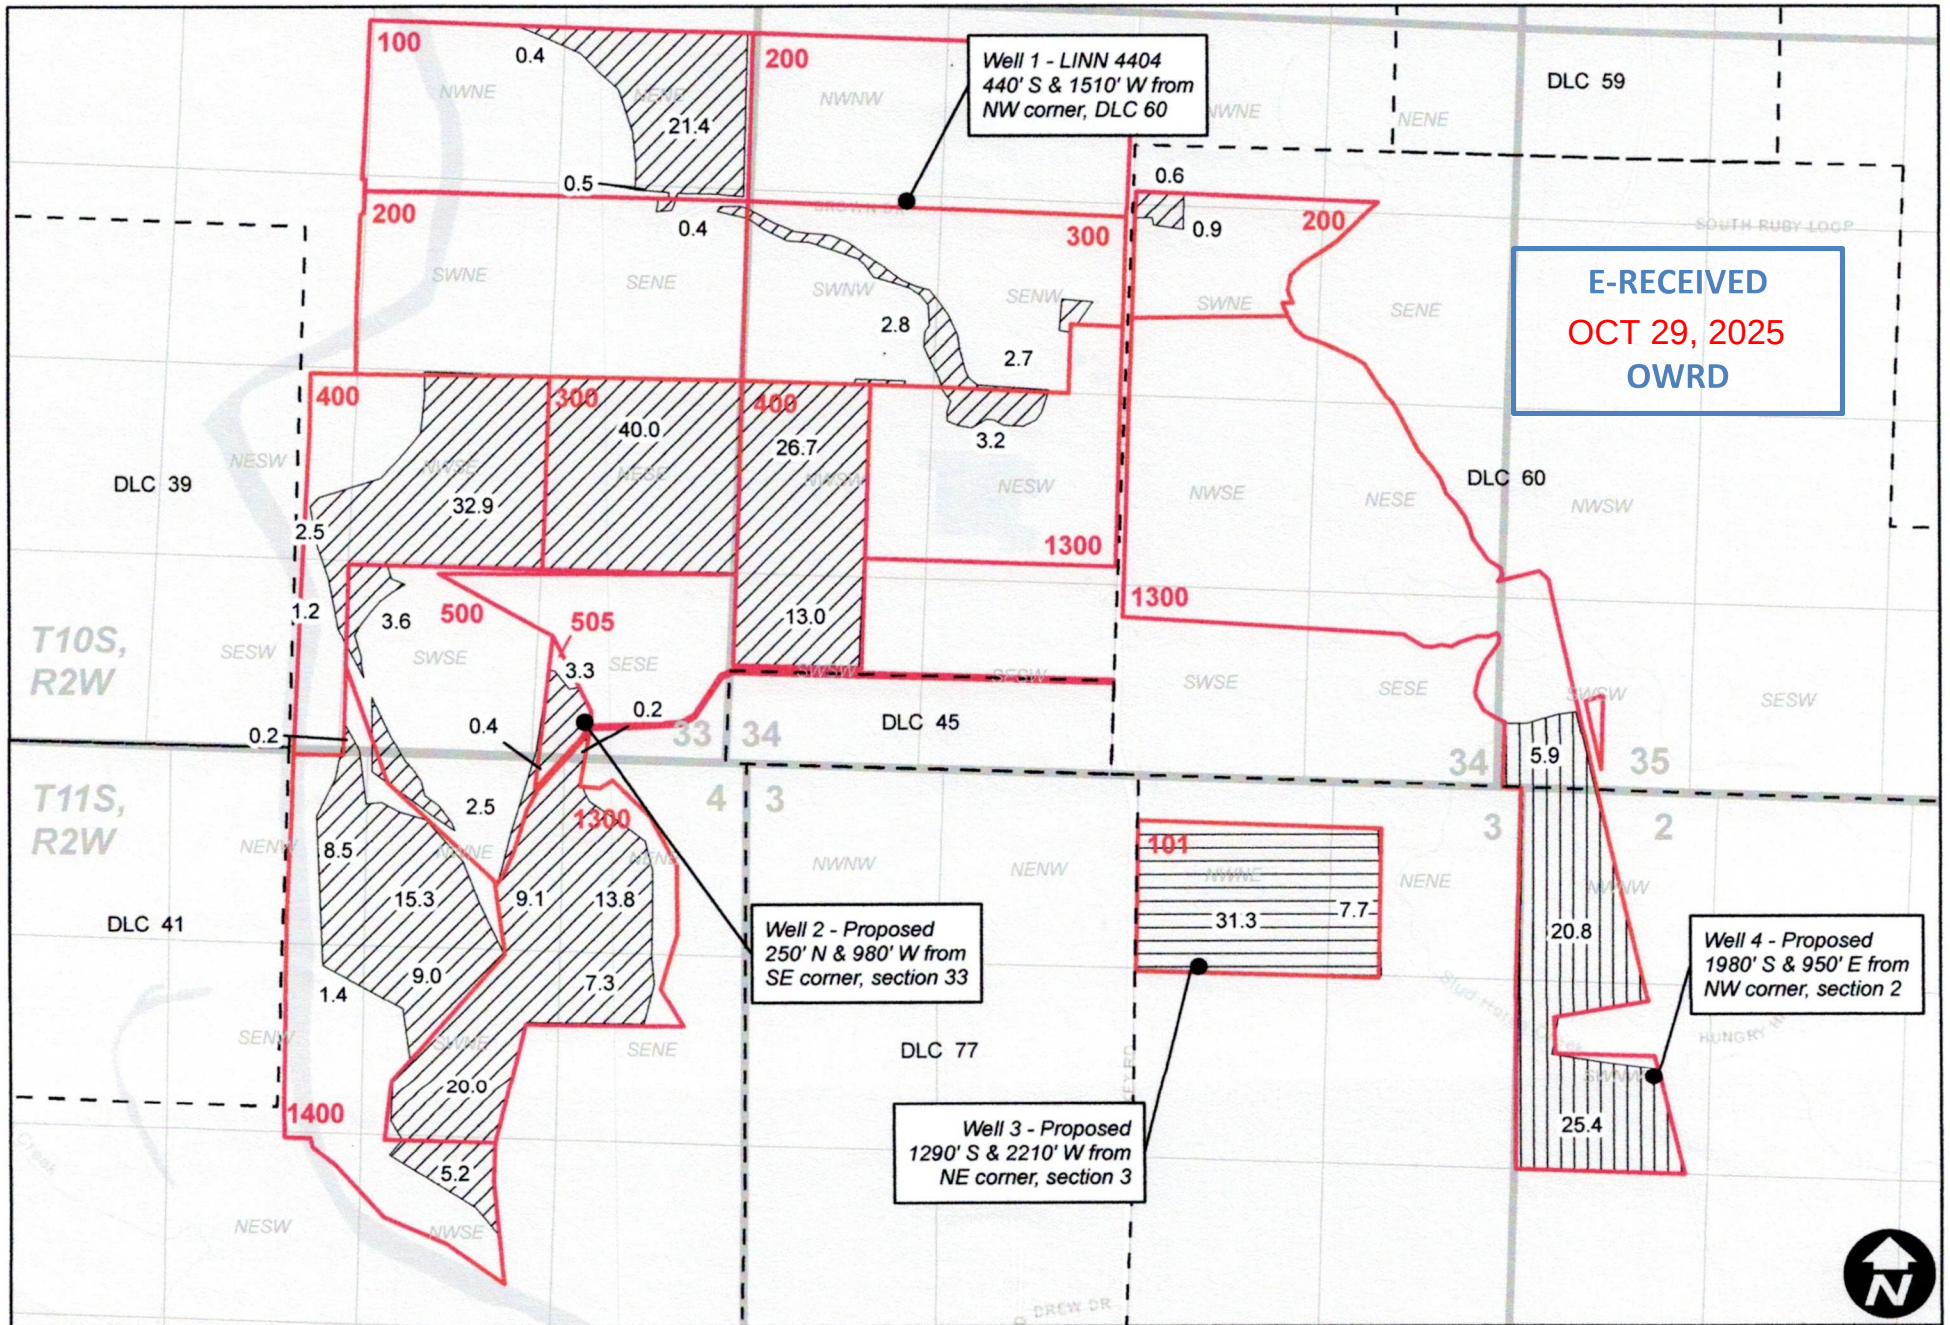

Legend

Well 4 Proposed POU (52.1) Well 3 Proposed POU (39.0) Well 1, 2 Proposed POU (249.0) DLC Tax Lots