


CLAIM OF BENEFICIAL USE MAP
TRANSFER # T-14457
SECTION 8 & 17, TOWNSHIP 39 SOUTH, RANGE 9 EAST, W.M.
KLAMATH COUNTY, OREGON

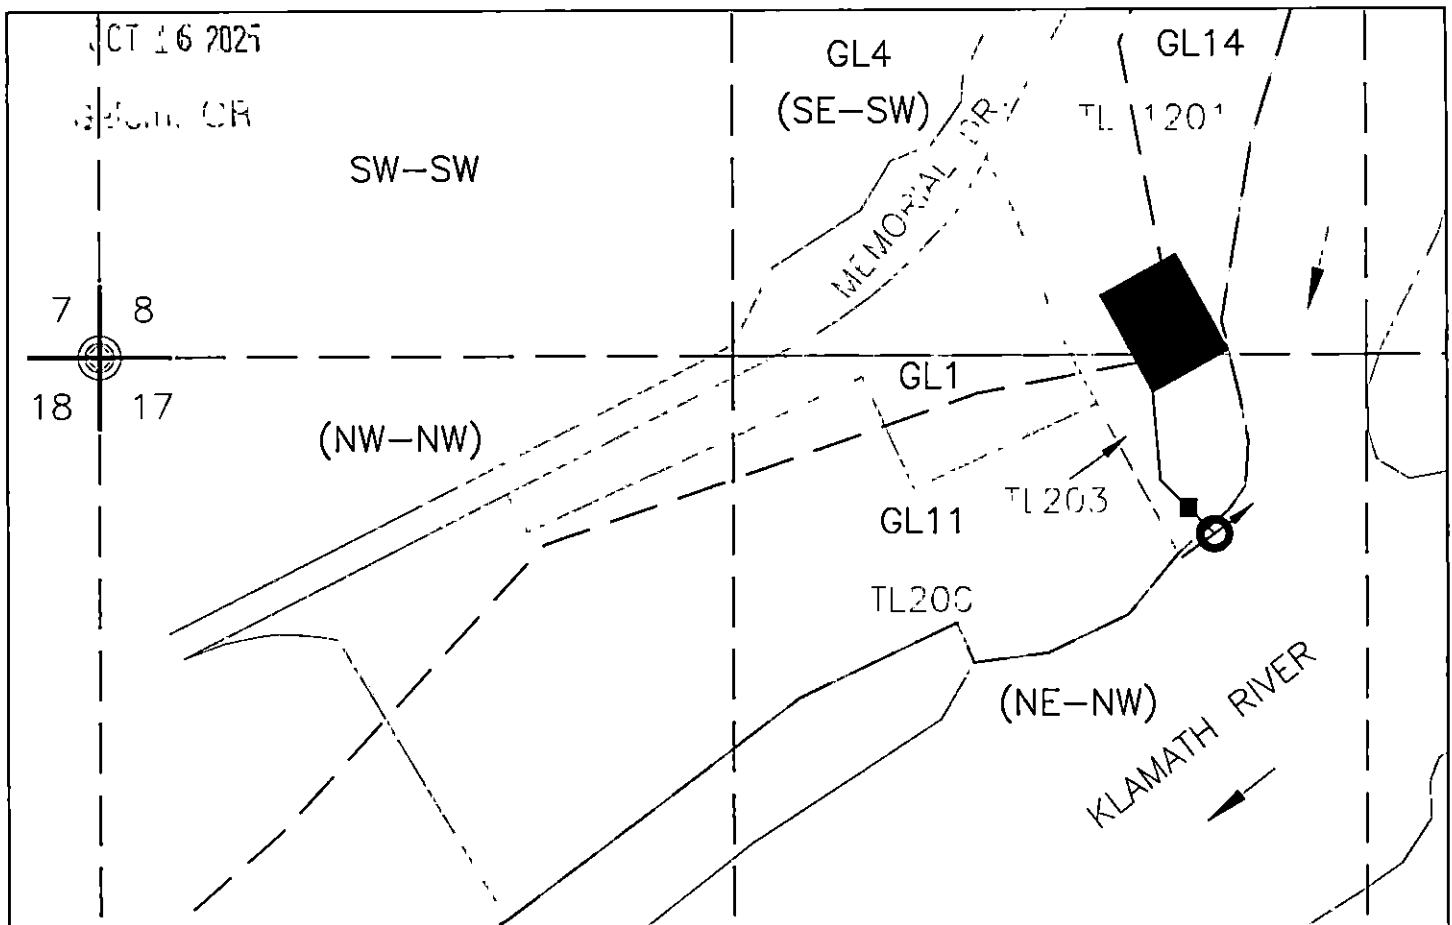

LEGEND



REFERENCE CORNER (RC)

-N.W. COR. SECTION 17, T.39S., R.9E., W.M.



POINT OF DIVERSION (POD)

-POD#1 (PROPOSED) 371 FT. S. &
2323 FT. E. FROM RC. w/ ODFW APPROVED FISH
SCREEN



PUMP VAULT & TOTALIZING FLOW METER
MAINLINE



TAXLOT BOUNDARIES




1/16 SECTION (AS PROJECTED) &
GOVERNMENT LOT LINES



PLACE OF USE (POU)

FIRE SUPPRESSION SYSTEM

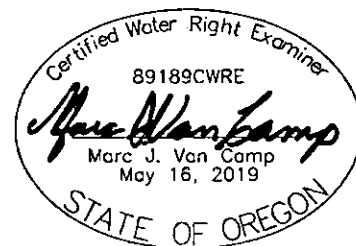

EXPIRES 06/30/2026



NORTH
1"=400'

DISCLAIMER: THIS MAP WAS PREPARED FOR THE
PURPOSE OF IDENTIFYING THE LOCATION OF
WATER RIGHT ONLY AND IS NOT INTENDED TO
PROVIDE LEGAL DESCRIPTIONS OR LOCATIONS OF
PROPERTY LINES.

VCC

**VAN CAMP
CONSULTING**

P.O. Box 995
Coos Bay, OR 97420
(541) 297-1880
vancampconsulting@gmail.com

Prepared For:
Panel Processing, Inc.
3090 Memorial Drive
Klamath Falls, OR
97601

Project:
Claim of Beneficial Use
T-14457

Date:
AUG. 31, 2025