


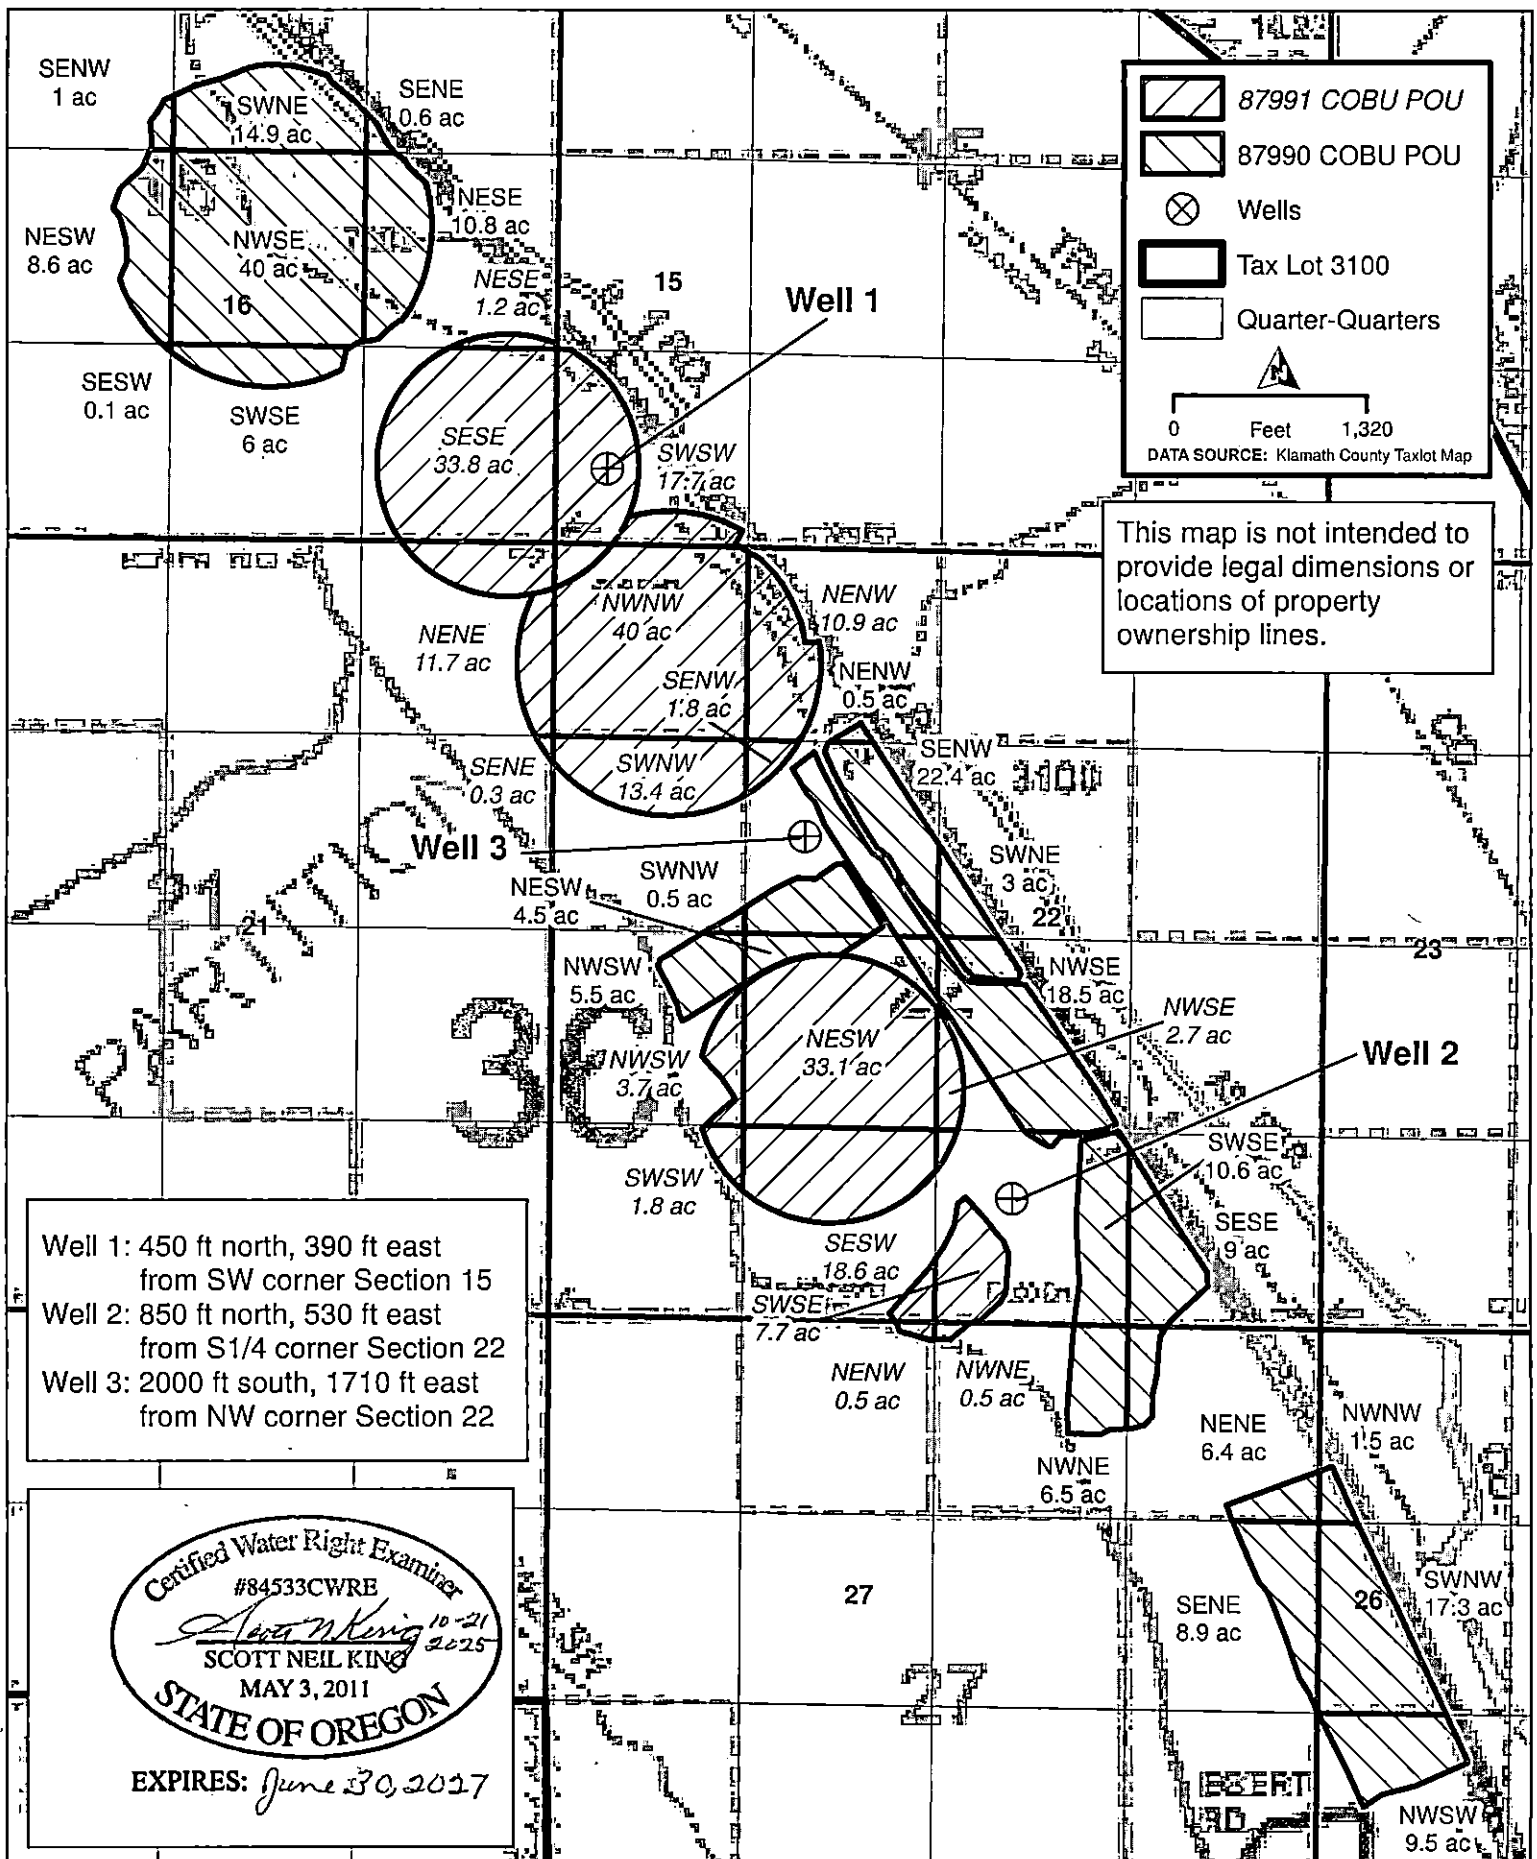

T 37 S R 11 1/2 E W.M.
 Sections 15, 16, 22, 26, 27
 Klamath County Tax Lot 3100

CLAIM OF BENEFICIAL USE MAP

T-12762

AMARAL CHAPMAN RANCH LLC