
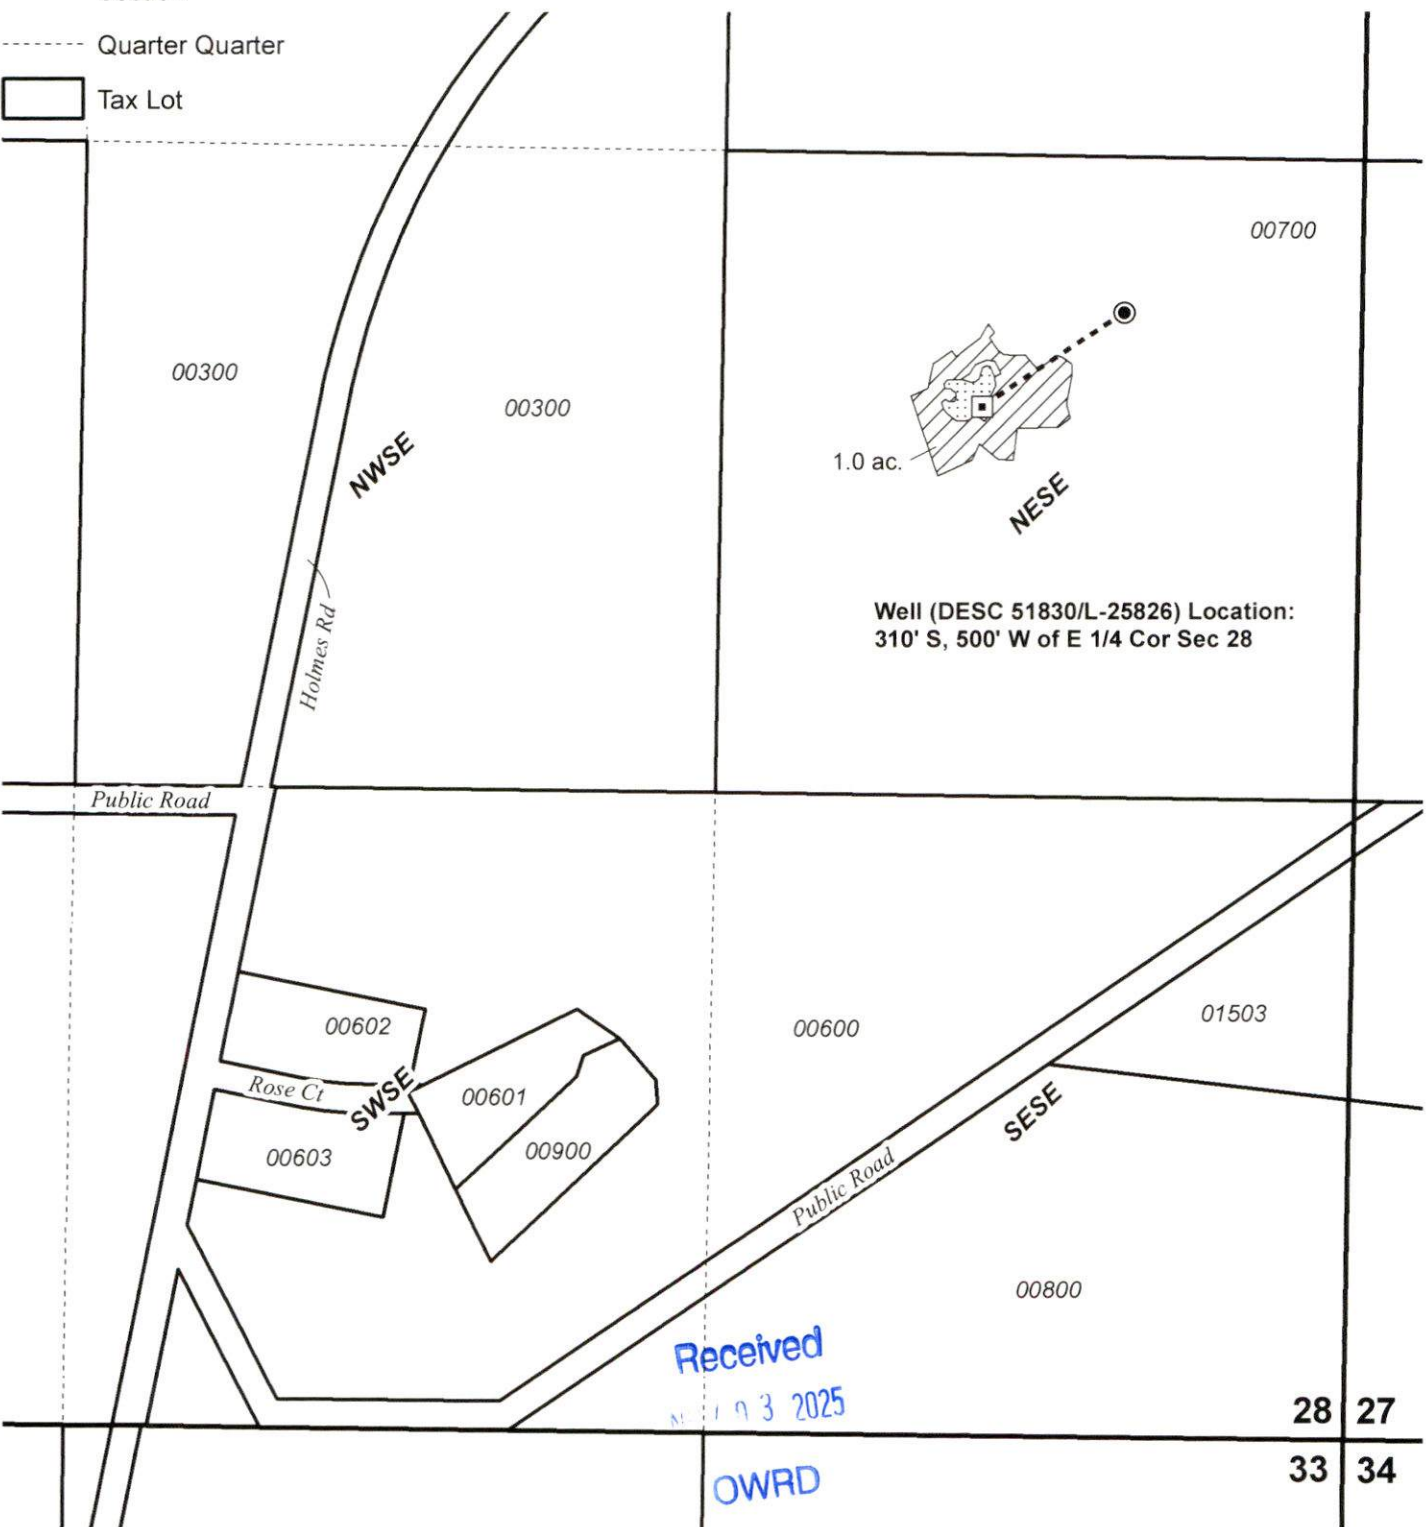


T14S R11E, WM
DESCHUTES COUNTY, OR

- Well & Cistern
- Meter
- Pipeline
- Bulge
- Place of Use - Irrigation
- Section
- Quarter Quarter
- Tax Lot

Certified Water Right Examiner
103749
Bryce
Bryce Michael Withers
July 9, 2024
STATE OF OREGON
RENEWS: 06/30/2026

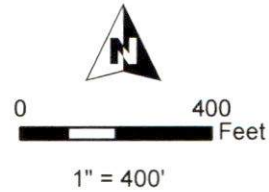

CLAIM OF BENFICIAL USE MAP
Wand

This map is not intended
to provide legal dimensions
or locations of property
ownership lines.

WATER RIGHT SERVICES, LLC
PO BOX 1830, BEND, OR 97709
WWW.OREGONWATER.US CCB # 197121
brycewrs@gmail.com 541-389-2837