


T 41 S, R 18+19 E, WM, Sections 7, 12, 13 LAKE COUNTY

POINT OF APPROPRIATION

Groundwater Well (Well Log LAKE 2909)

Located in the NW NE Section 13, T41S, R18E, WM
150 ft S and 50 ft E from the N 1/4 Corner of Sec 13.


Required meter (electric) in same location.

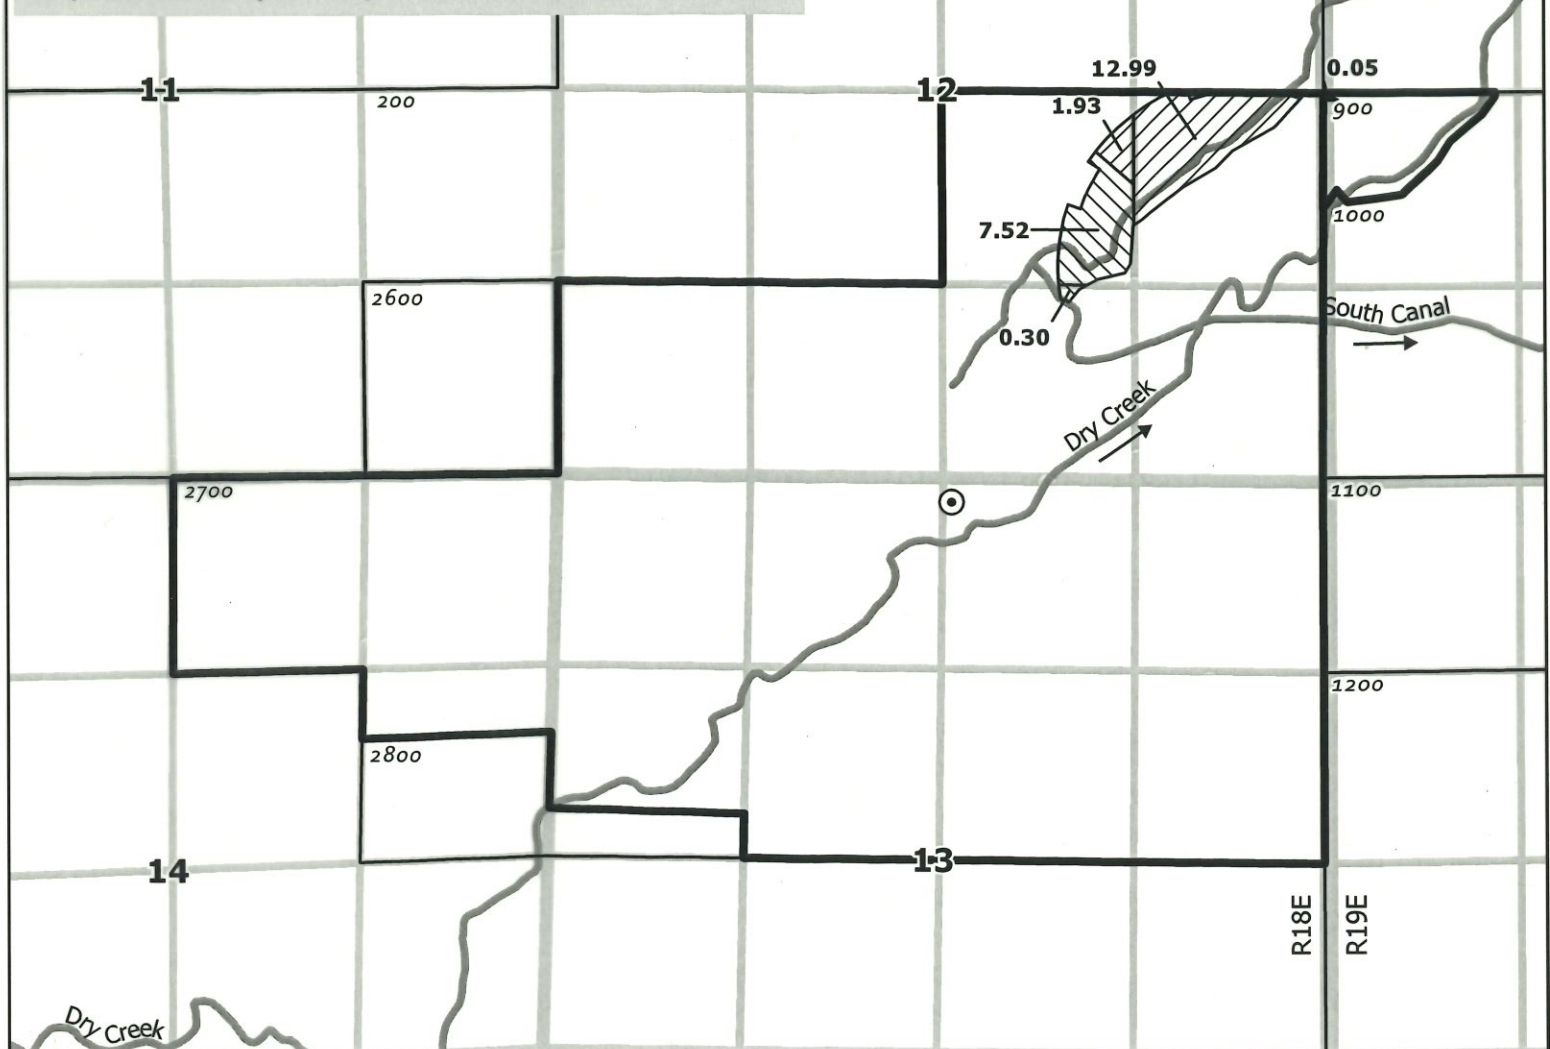


- | | |
|---------------------|-----------------------|
| C-58072_Transfer_TO | PLSS Quarter Quarters |
| C-58074_Transfer_TO | PLSS Sections |
| POA (Well) | PLSS Township |
| Taxlot Owned | Water Courses |
| Lake County Taxlots | |

Received
OCT 31 2025
OWRD

DISCLAIMER
This map is not intended
to provide legal
dimensions or locations
of property ownership
lines

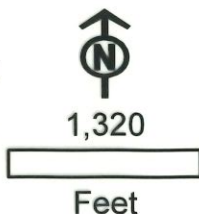

WATERSOLVING
johnw@watersolving.com
541-815-4103

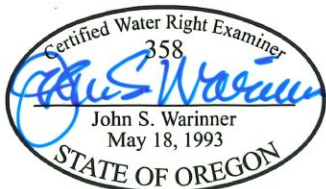

CLAIM OF BENEFICIAL USE MAP

TRANSFER 13856
in the name of
MICHAEL PLECHATY

2025-10-01