


T.2S., R.32E., W.M., UMATILLA COUNTY, OREGON
CLAIM OF BENEFICIAL USE MAP UNDER TRANSFER NO. T-11356
FOR TRUDY DRAPER

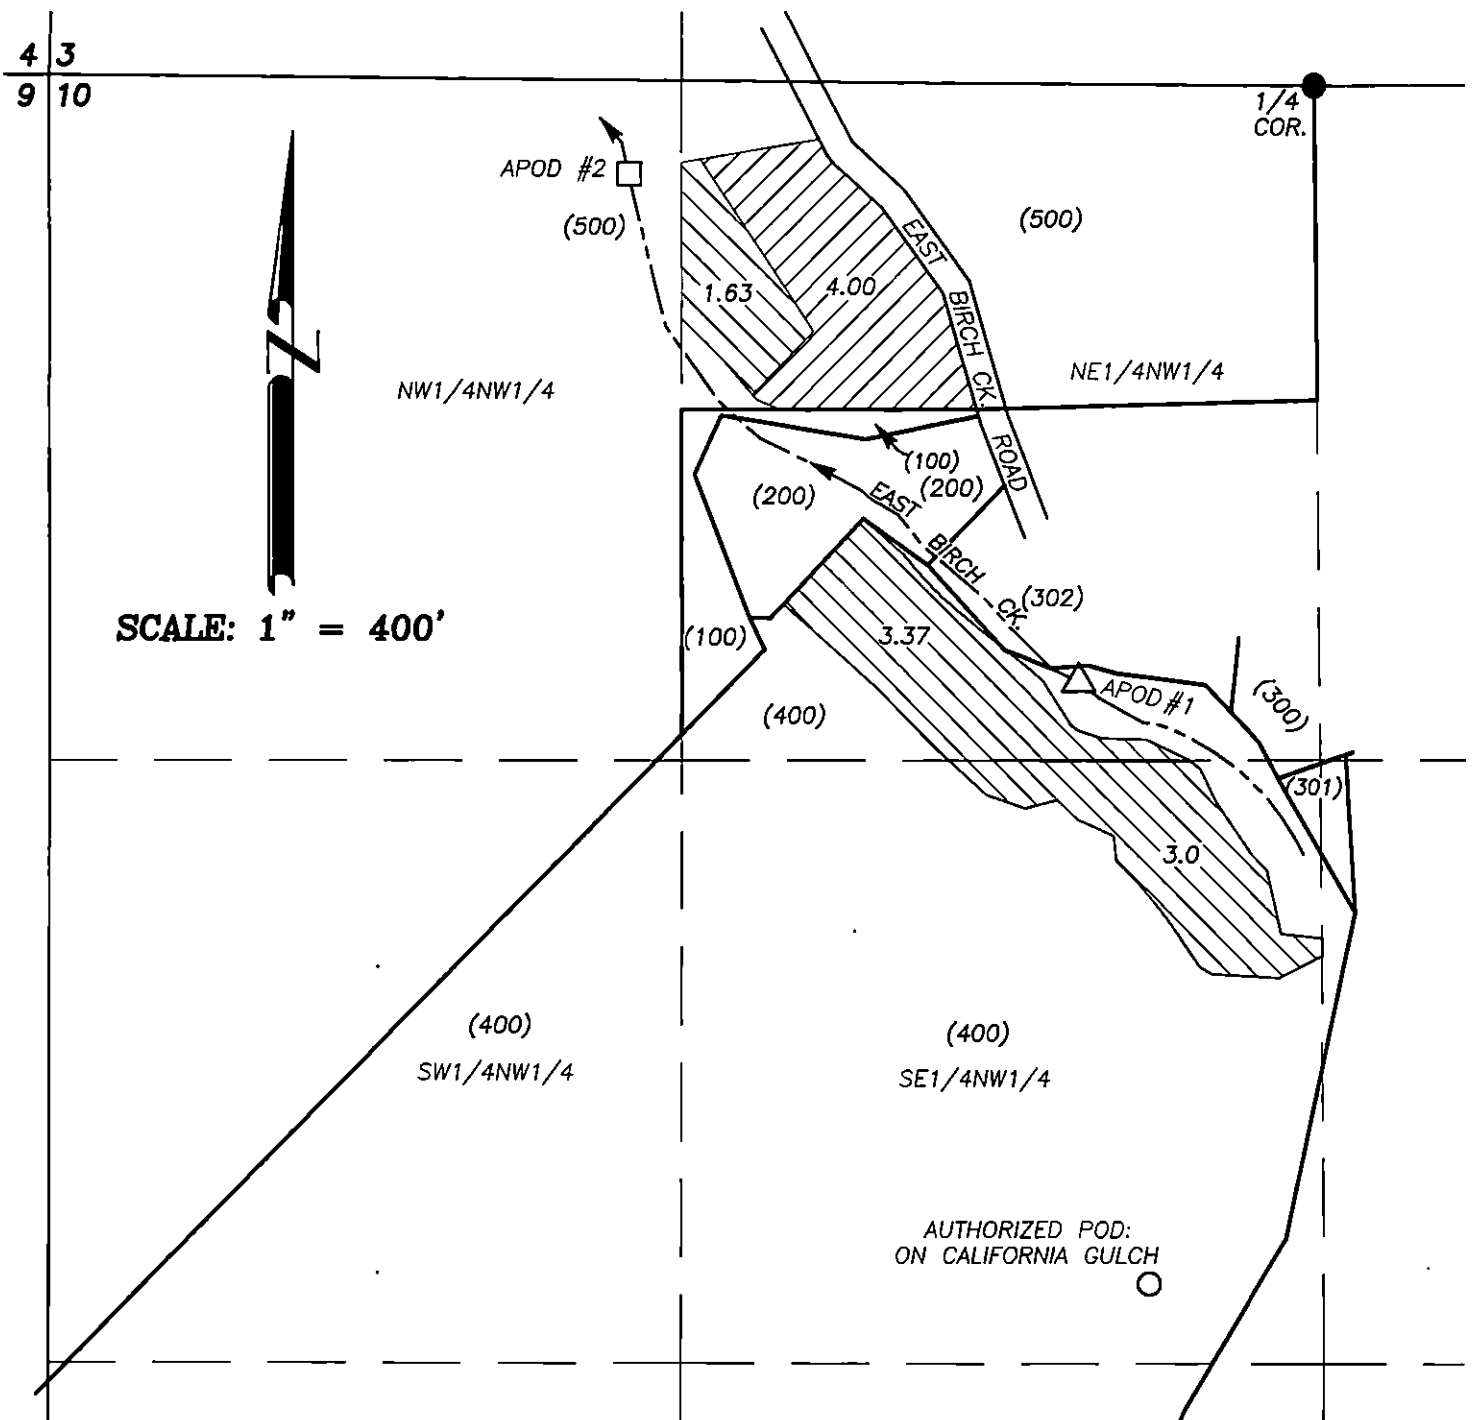

○ AUTHORIZED POD: S.07°53'31"W., 2499.32 FT. FROM N1/4 COR. SECTION 10, T.2S., R.32E.

△ APOD #1: PUMP WITH FISH SCREEN: 1230 FT. SOUTH & 490 FT. WEST FROM N1/4 COR. SECTION 10, T.2S., R.32E. FLOW METER BEARS S.40°W., 22 FT. FROM APOD #1

□ APOD #2: PUMP WITH FISH SCREEN: 180 FT. SOUTH & 1430 FT. WEST FROM N1/4 COR. SECTION 10, T.2S., R.32E. FLOW METER BEARS N.68°E., 27 FT. FROM APOD #2

▨ PRIMARY - PRIORITY DATE 1882: 4.0 AC.

▨ PRIMARY - PRIORITY DATE 1898: 8.0 AC.

() TAX LOT NO.

● FOUND RECORD DRILL STEEL MONUMENT AT N1/4 CORNER SECTION 10, T.2S., R.32E.