


CLAIM OF BENEFICIAL USE MAP

TO CHANGE PLACE OF USE
PER TRANSFER, T-14290
FOR TABLE ROCK HAY AND CATTLE, LLC


Received
NOV 07 2025

TOWNSHIP 28 SOUTH, RANGE 16 EAST, SECTION 11, W.M.
TAX LOTS: 400, 500, 2000, & 2100 LAKE COUNTY, OREGON

OWRD

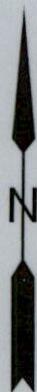

SCALE: 4 INCHES = 1 MILE

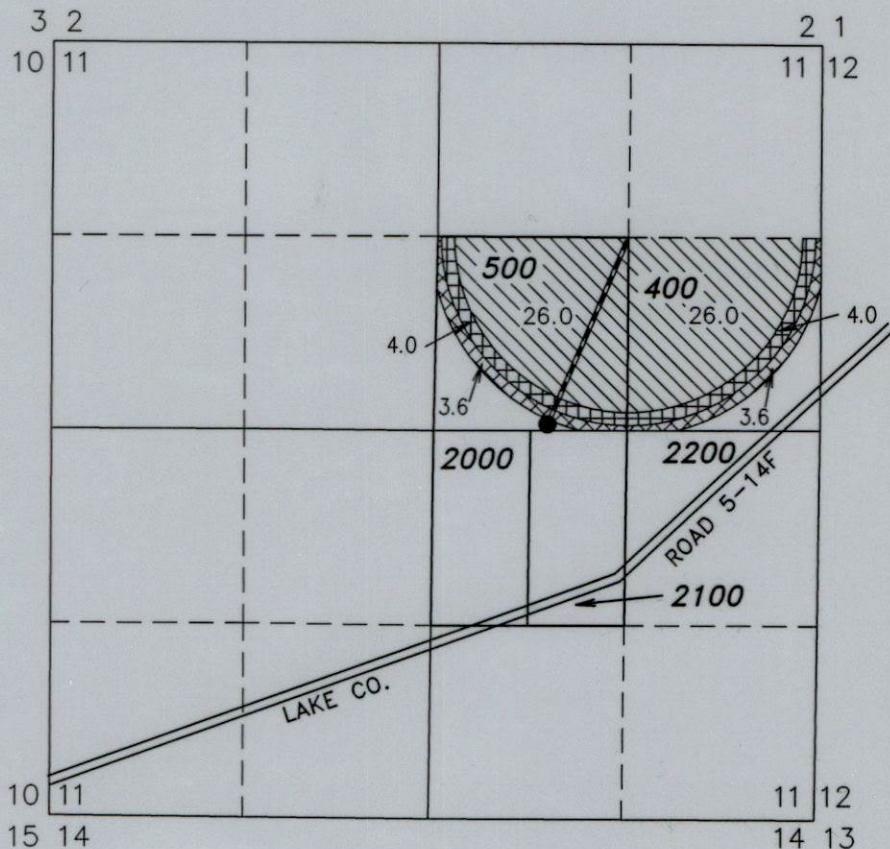

52.0 ACRES FROM G-10044
(CERT.# 86792) PER
T-14290, AS SHOWN

8.0 ACRES FROM G-10044
(CERT.# 88618) PER
T-14290, AS SHOWN

7.2 ACRES FROM G-10043
(CERT.# 95117) PER
T-14290, AS SHOWN



RENEWAL DATE: 12/31/2026

THIS MAP IS FOR THE PURPOSE OF LOCATING A WATER
RIGHT ONLY AND HAS NO INTENT TO PROVIDE LEGAL
DIMENSIONS OR THE LOCATION OF PROPERTY LINES

● #3
EXISTING WELL #3 (LAKE 1386)
30' NORTH & 780' EAST FROM THE C 1/4 CORNER
SECTION 11.

METER IS LOCATED ON THE DELIVERY PIPE 6 FEET
NE'LY OF THE WELL

PREPARED FOR:

NATHANIEL CHURCH
P.O. BOX 238
CHRISTMAS VALLEY, OR 97641

PREPARED BY:



ALL POINTS ENGINEERING AND SURVEYING, INC.
P.O. BOX 767
(541) 548-5833

TERREBONNE, OR 97760
www.APEandS.com