

CLAIM OF BENEFICIAL USE MAP

GROUND WATER – NURSERY USE

APPLICATION: G-18607

PERMIT: G-18153

FOR

DAVID DUDDY




PO BOX 2517

WHITE CITY, OR 97503

SITUATED IN

SECTION 11, TOWNSHIP 35 SOUTH, RANGE 2 WEST, W.M.
JACKSON COUNTY, OREGON

RENEWES: 12/31/2026

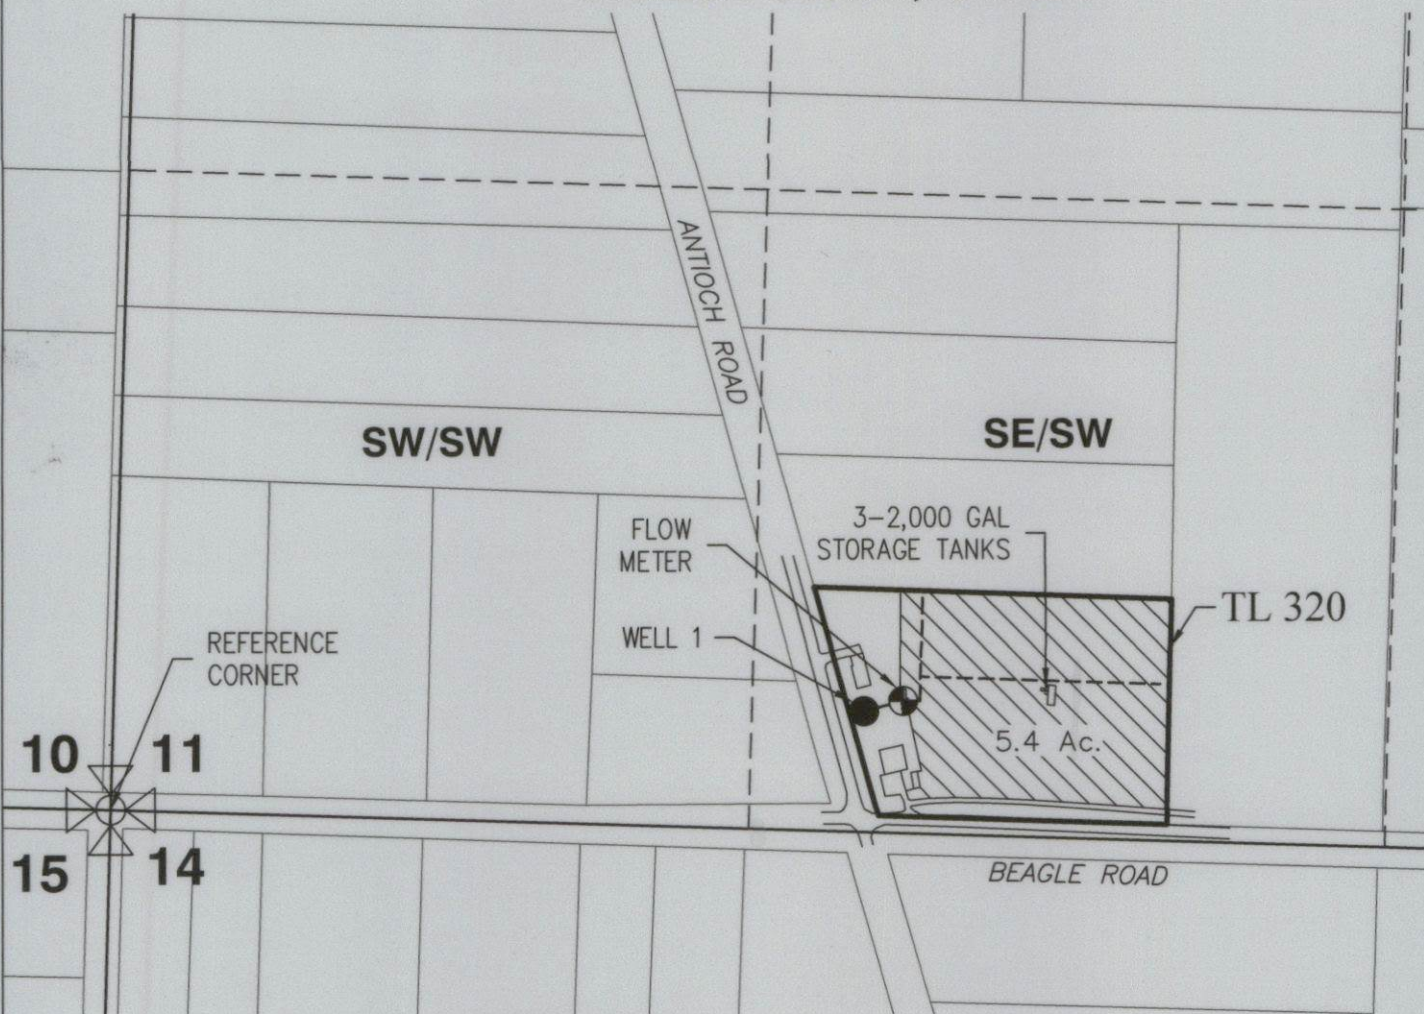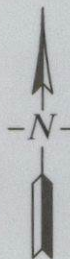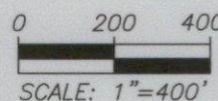

LEGEND



POINT OF APPROPRIATION

WELL 1: 202' NORTH AND 1567' EAST
FROM THE SOUTHWEST CORNER OF
SECTION 11



PLACE OF USE
IRRIGATION INCLUDING NURSERY

----- 1/4-1/4 SECTION LINE

----- BURIED WATERLINE (APPROX.)

This map is not intended to
provide legal dimensions or
locations of property
ownership lines.

Received
NOV 10 2025
OWRD

EHM-November 4, 2025

ROGUE CIVIL LLC
emalepsy@roguecivil.com 541-621-2868