


# T8S R46E WM

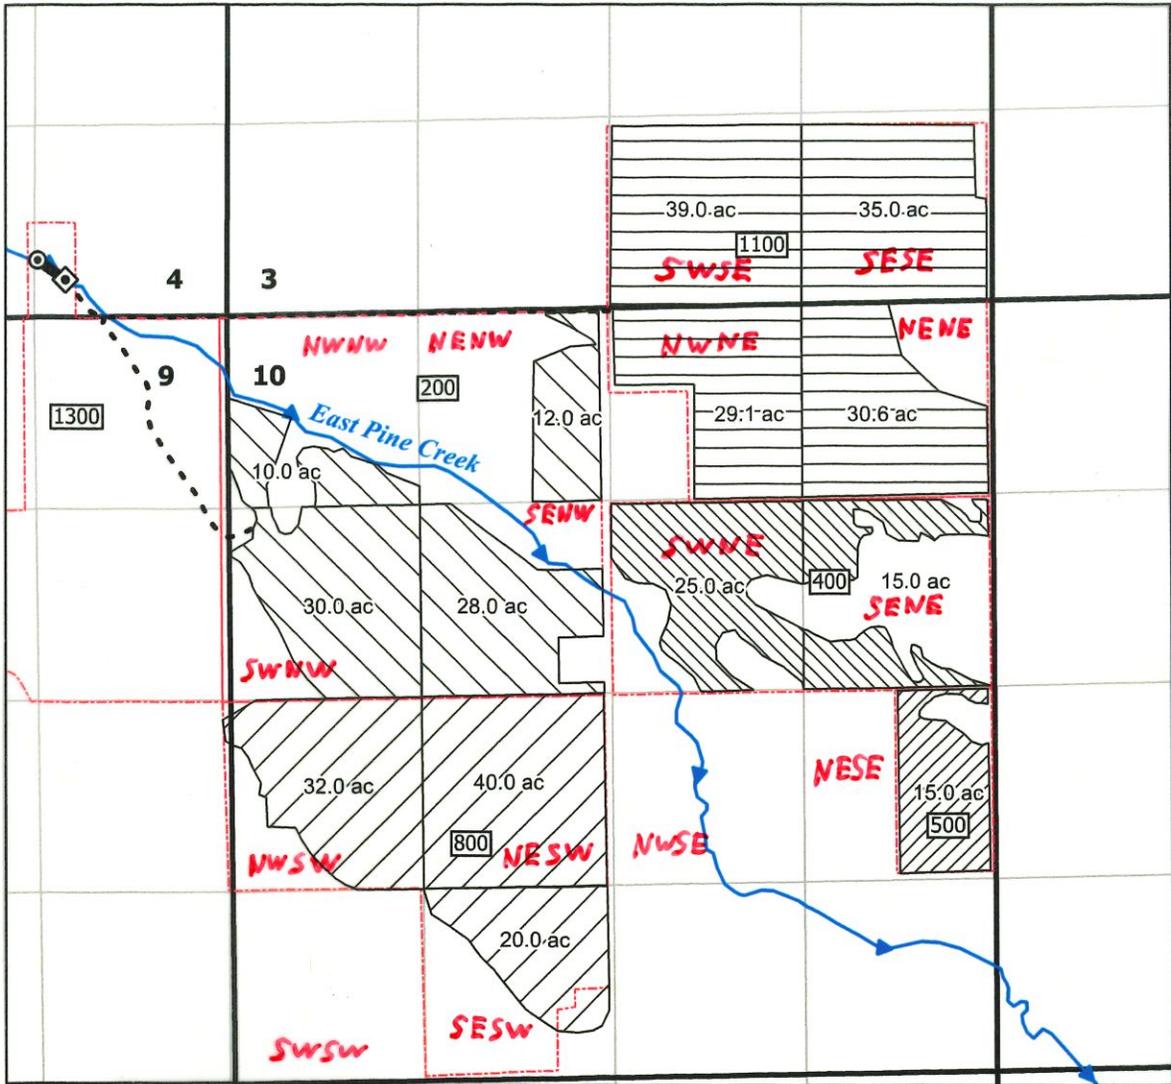

LEGEND			
	10424		Authorized POD
	36813		Fish Screen
	46652		16" Pipe
	85796		Ditch
	95484		Baker County Taxlot Boundary

Received  
OCT 17 2025  
OWRD



## Map to Accompany Claim of Beneficial Use Transfer T-13993 Halfway, OR

Prepared on behalf of Idaho Power Company

1 inch = 1,320'



### Notes:

This map is not intended to provide legal dimensions or locations of property ownership lines.

16" diameter buried PVC pipe conveys water from the POD to the fish screen

Fish diversion located at the POD and Fish screening located approximately 250 ft southeast of the POD