


Claim of Beneficial Use

Transfer T-13542

A Water Right held by AGC Properties, LLC
Washington County

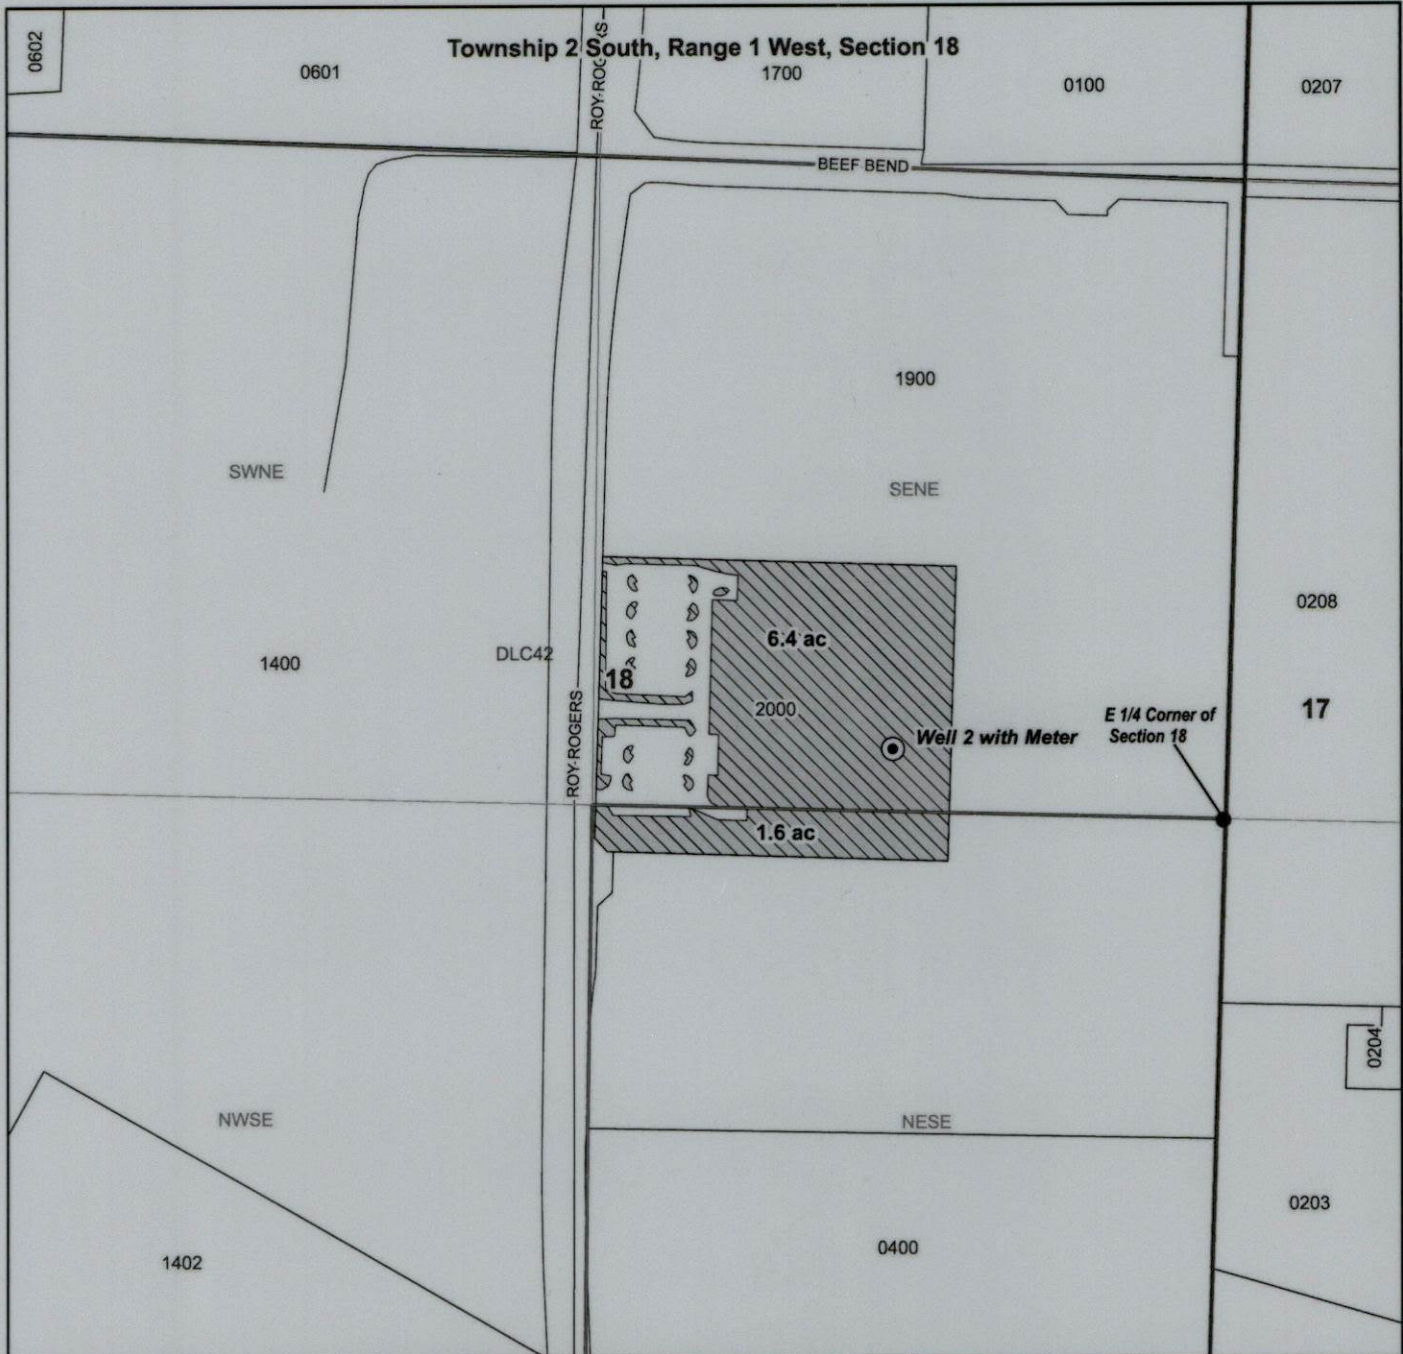

LEGEND

- Point of Appropriation (POA)
- ▨ Place of Use (POU) 8 ac
- Roads
- Tax Lots

POA Location Description



Well 2 (WASH 81878, L-151655)
Located 125 feet North and 700 feet West from the E 1/4 Corner of Section 18 (SENE), Township 2 South, Range 1 West, W.M.

Received
NOV 17 2025

OWRD

Received
NOV 05 2025

OWRD

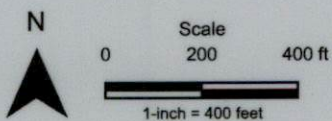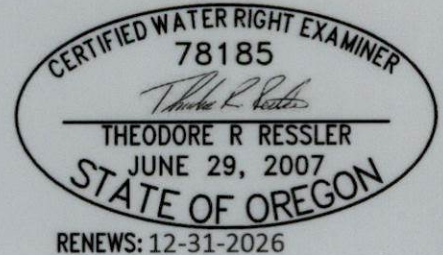

Date: 10/22/2025
Data Sources: BLM, OWRD, ODFW, USGS, Washington County.
Disclaimer: This map is not intended to provide legal dimensions or property ownership lines.

