


TOWNSHIP 14 SOUTH, RANGE 8 WEST, W.M.

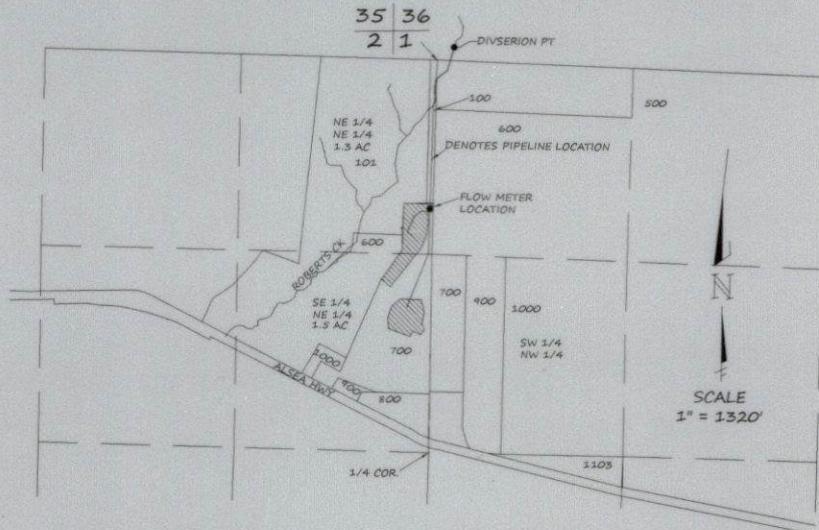

T-13848

POD LOCATION:
90' NORTH & 180' EAST
S.W. COR. SECTION 36

FLOW METER LOCATION:
1015' SOUTH & 57' WEST
OF S.W. COR. SECTION 36


DENOTES AREA OF
BENEFICIAL USE

Special Order Volume 133, Page 435

CLAIM OF BENEFICIAL USE MAP
FOR
TERRY CUTSFORTH
38460 MARYS RIVER ROAD
BLODGET, OR 97326
BY

H. TIMOTHY FASSBENDER, PLS, CWRE
2896 SARAH LANE
EUGENE, OR. 97408
OCTOBER 11, 2025

NOTE:
THIS MAP WAS PREPARED FOR THE
PURPOSE OF IDENTIFYING THE LOCATION
OF THE WATER RIGHT ONLY. IT IS
NOT INTENDED TO PROVIDE DIMENSIONS
OR LOCATION OF PROPERTY OWNERSHIP
LINES.

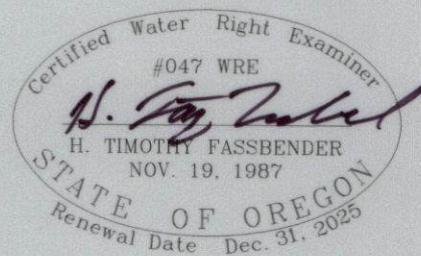

Received Received
OCT 30 2025 NOV 17 2025
OWRD OWRD