



Oregon Water Resources Department
725 Summer Street NE, Suite A
Salem, Oregon 97301
(503) 986-0900
www.oregon.gov/OWRD

Received
NOV 12 2025
OWRD

Ownership Update for Certificated Rights Only

NO FEES ARE REQUIRED TO SUBMIT THIS FORM

NOTICE: A certificate of water right typically stays with the land. To track water right ownership, the Department requests that this form be submitted to the Department. **To update multiple rights, a separate form is required for each right.** If you have any questions about this form, please contact your local watermaster, or call the Water Resources Department at (503) 986-0900.

Note: Use the [assignment](#) form to change ownership on pending applications, permits, transfers, groundwater registrations, or limited licenses.

Current Landowner Information					
Name:	Avion Water Company Inc., Attn: Adam Jackson				
Mailing Address:	60813 Parrell RD				
City:	Bend	State:	OR	Zip:	97702
Phone:	541.382.5342	Email:	adam@avionwater.com		

Property Information							
County:	Deschutes	Township:	17 S	Range:	11 E	Section:	13
Tax Lot #:	800 - Well locations						
Street Address of Water Right:	N/A - Quasi-Municipal Water Right						
Water Right Information							
Application:	G-14288						
Permit:	G-13153						
Certificate:	89406						
Are all the lands associated with this water right owned by the requestor?				☐	Yes	☒	No
(If no, include a map showing the portion of the water right involved) - N/A: Owner is quasi-municipal service							

Signature and Date			
Name of individual completing form:	Trevor Grandy, RG, CWRE		
Phone or email:	tgrandy@gsiws.com	Date:	11/7/2025
Signature of requestor:			

The Department does not change names on water right certificates. This form will be placed in the file for future reference only. If mailed, the Department will not provide acknowledgment of receipt.

This form can be mailed to the address above or sent by email to wrd_dl_customerservice@water.oregon.gov




1" = 1320'

RECEIVED BY OWRD

FEB 12 2013

SALEM, OR

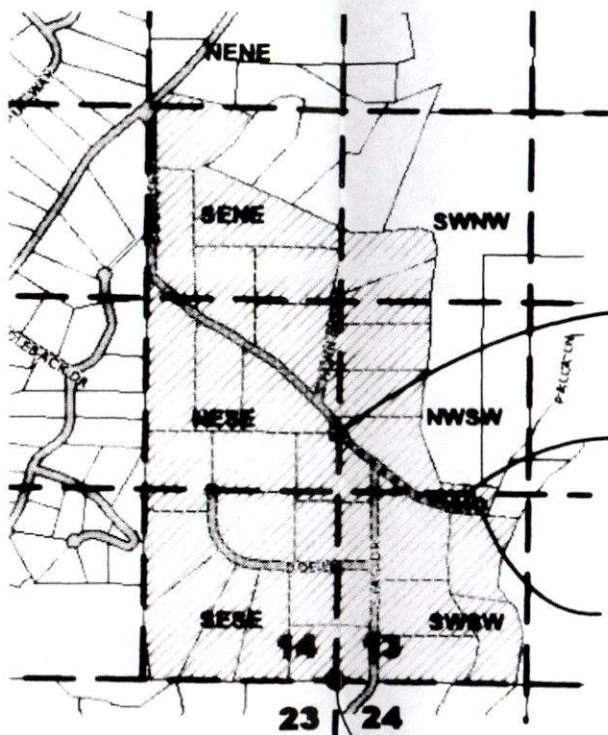

CISTERN
AND PUMP


WELL #3 & METER
1260' NORTH,
880' EAST FROM
SW CORNER,
SECTION 13

WELL #2 & METER
1220' NORTH,
990' EAST FROM
SW CORNER,
SECTION 13

SW CORNER OF SECTION 13



POU - QUASI-MUNICIPAL

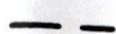

QUARTER QUARTER
BOUNDARIES

..... PIPELINE

NOTE: THIS MAP IS NOT INTENDED TO
PROVIDE LEGAL DIMENSIONS OR LOCATIONS
OF PROPERTY OWNERSHIP LINES.

DESCHUTES COUNTY, OREGON

T 17 S, R 11 E, W.M.

SECTION 13 SWNW
NWSW
SWSW

SECTION 14 NENE
SENE
NESE
SESE


APPLICATION G-14288

PERMIT G-13153

Received

NOV 12 2025

OWRD

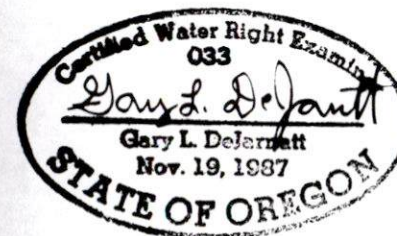

RENEWAL DATE: 12-31-2013

TITLE

CLAIM OF BENEFICIAL USE MAP for
KLIPPEL WATER, INC.

WATER RIGHT SERVICES, LLC

WWW.OREGONWATER.US

P.O. BOX 1830, BEND OR 97709

(541) 389-2837

DATE

FEB 1, 2013

JOHNSHORT@USA.COM

JOB #

13003