


Claim of Beneficial Use

Permit R-14882, Application R-87487

A Water Right held by Alldenvale Properties LLC
Clackamas County

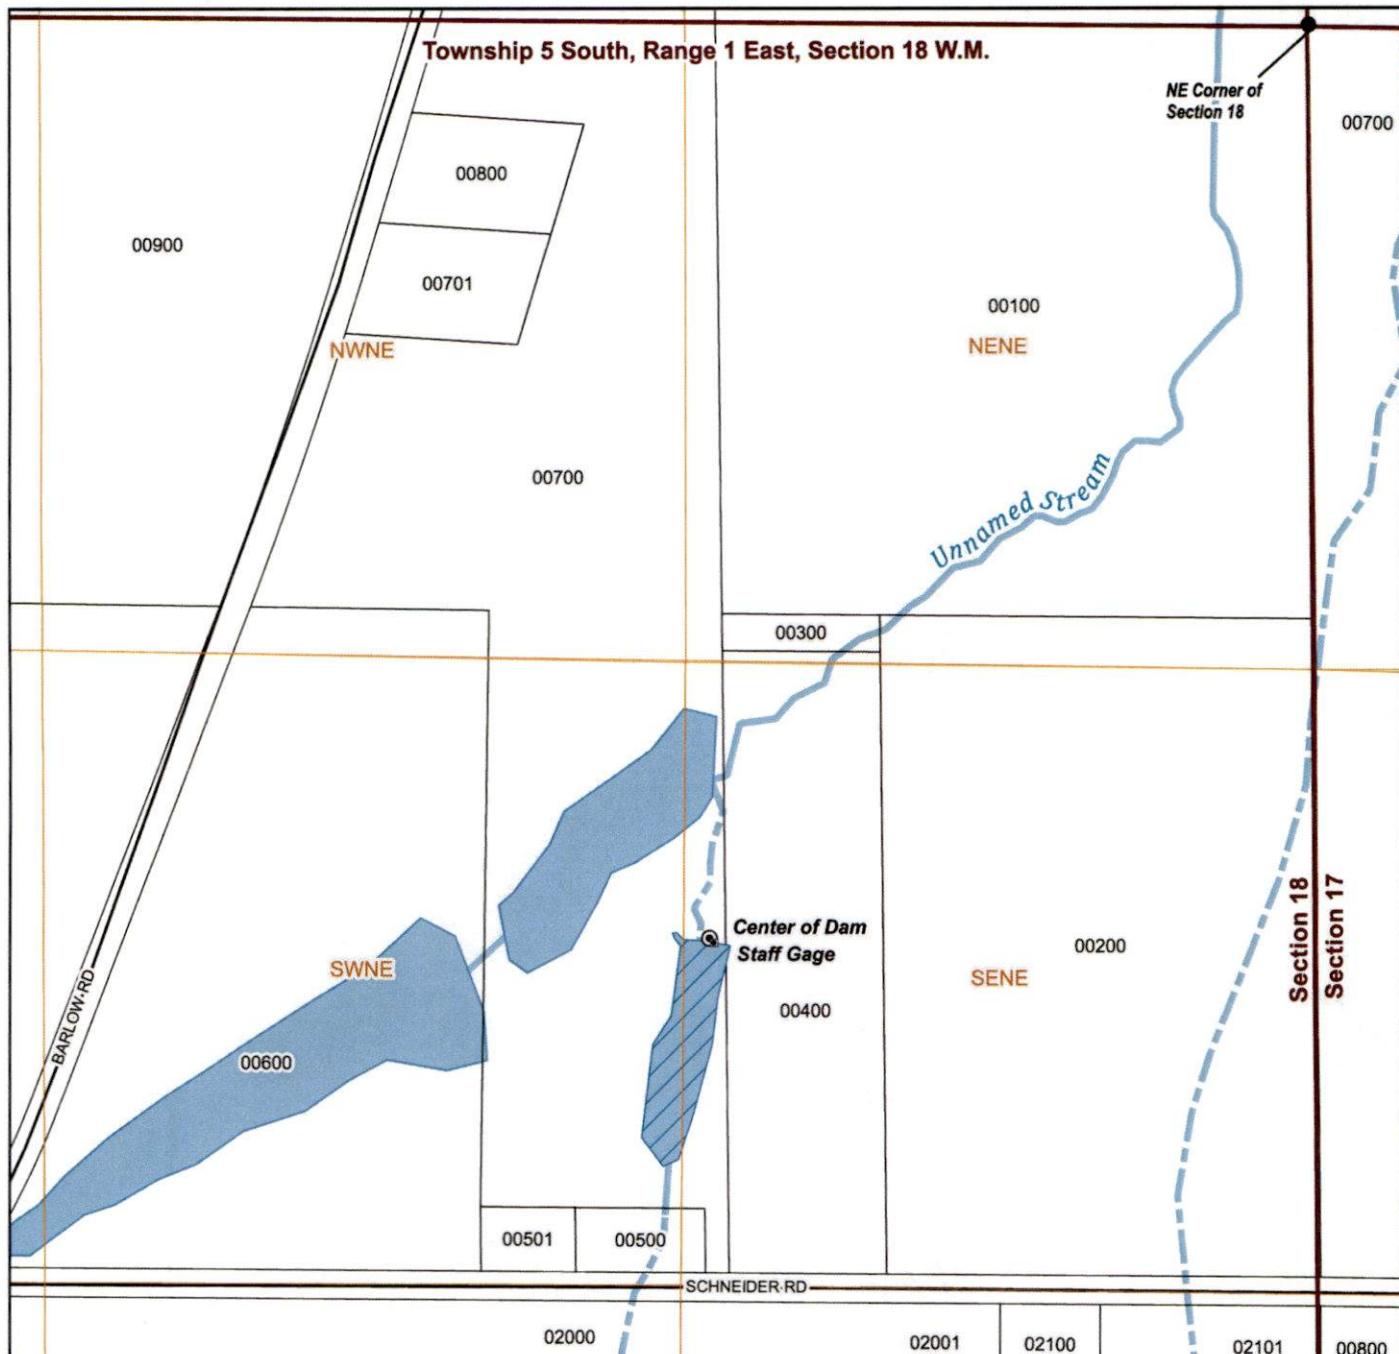

Project\Willamette_Nurseryseries\0_GIS\1_SWR_Files\1_SWR_Maps\R_14882_COBU_Map.qgz

LEGEND

- Point of Diversion (POD)
- Staff Gage
- Place of Use (POU)
- Perennial Watercourse
- - - Intermittent Watercourse
- Waterbody
- Tax Lots



Scale
0 200 400 ft
1-inch = 400 feet

POD Location Description

Center of Dam

Located 1890 feet South and 1266 feet West from NE corner of Section 18, Township 5 South, Range 1 East, W.M.

Received

NOV 18 2025

OWRD

Date: 10/7/2025
Data Sources: BLM, OWRD, OGEO, ODFW, USGS, Clackamas County.
Disclaimer: This map is not intended to provide legal dimensions or property ownership lines.

