
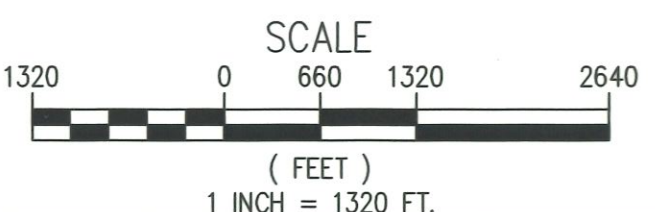
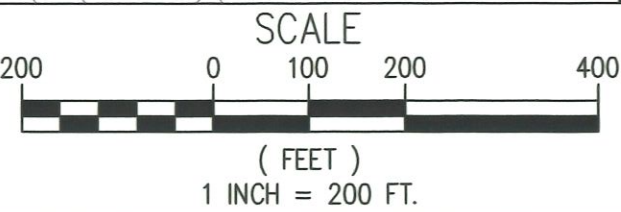
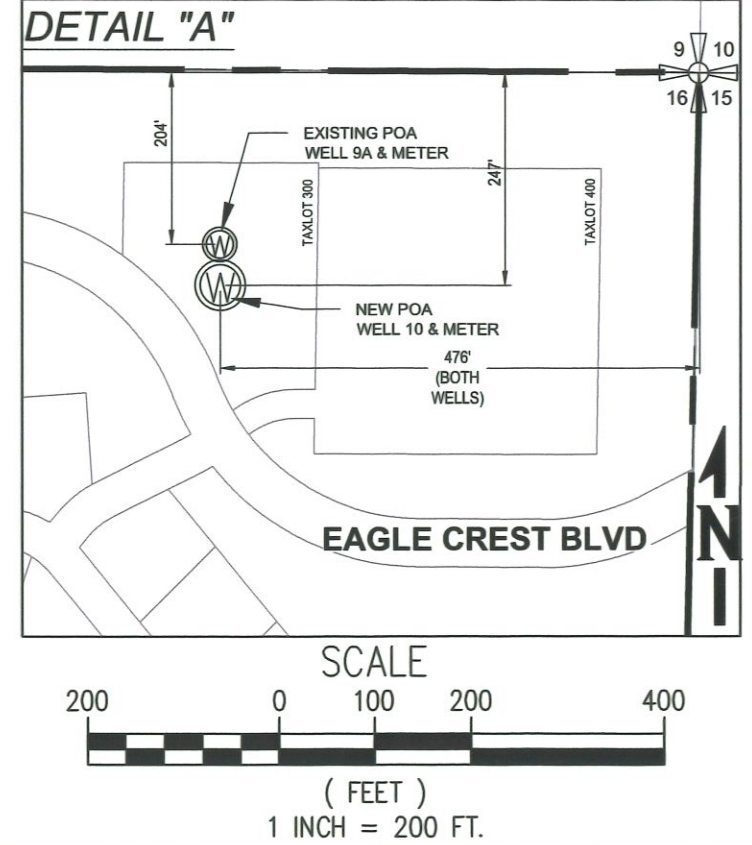


COBU MAP # 2163

LAYOUT: COBU T-13950 11X17
PATH: U:\Bend\Projects\Clients\Oregon Water Utilities\297-8010-018 Cline Butte Eagle Crest Well 10\995vca\CADD\DWG\COBU Map
PLOTED BY: OtterAny DATE: Thursday, November 20, 2025 1:25:36 PM

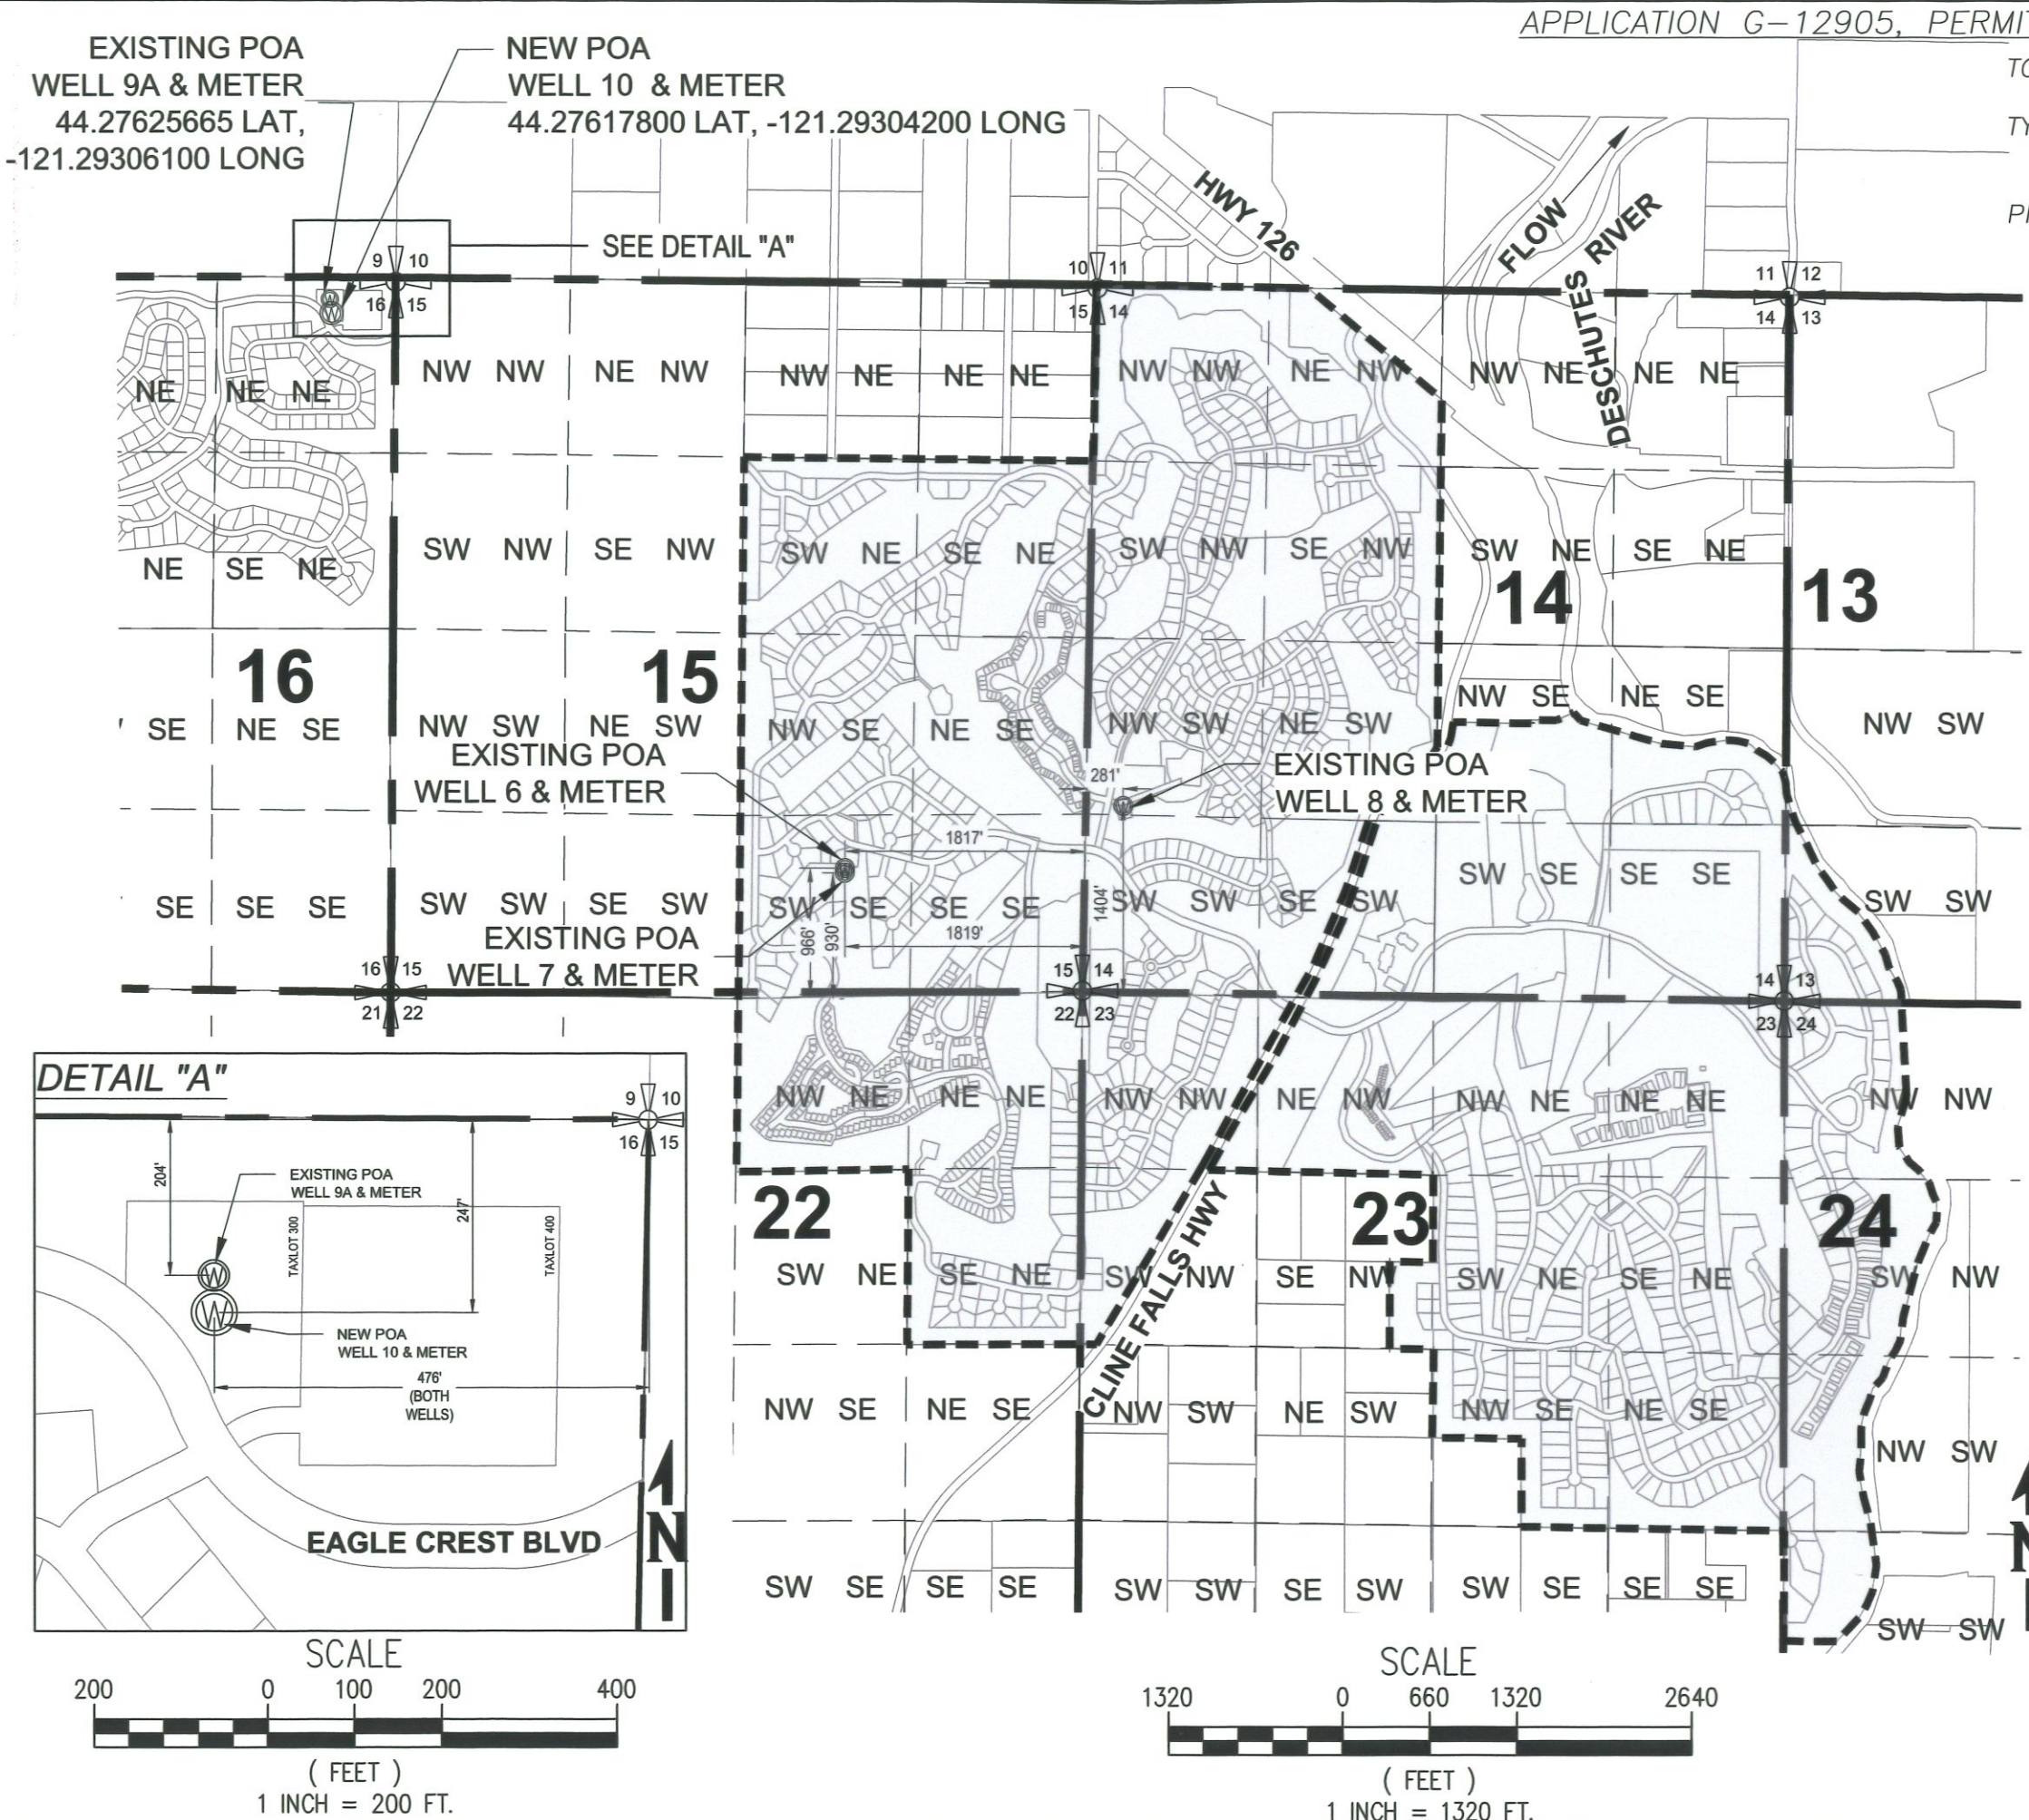

APPLICATION G-12905, PERMIT G-11762, TRANSFER T-13950
TOWNSHIP 15S, RANGE 12E, SECTION 16
TYPE OF USE:
QUASI-MUNICIPAL
PRIORITY DATE:
MAY 4, 1992

Received by OWRD
NOV 21 2025
Salem, OR

LEGEND

- WELL 9 POINT OF APPROPRIATION UNDER TRANSFER T-13950
- WELL 10 POINT OF APPROPRIATION ADDED BY TRANSFER T-13950
- AREA OF USE UNDER T-13950
- SECTION LINE
- TAXLOT LINE
- QUARTER SECTION LINE
- SECTION CORNER

NOTE: THIS MAP WAS PREPARED FOR THE PURPOSE OF IDENTIFYING THE LOCATION OF WATER RIGHTS. THIS MAP IS NOT INTENDED TO PROVIDE LEGAL DIMENSIONS OR THE LOCATION OF PROPERTY OWNERSHIP LINES.



EXPIRES: 12-31-2027

BY				
DATE				
REVISIONS				
ONE INCH AT FULL SCALE NOT SCALE ACCORDINGLY				

Parametrix

DATE	10/30/2025
DESIGNED	AO
DRAWN	AO
CHECKED	SPR
APPROVED	NWB

PROJECT NAME

OREGON WATER UTILITIES, INC.

TRANSFER T-13950

CLAIM OF BENEFICIAL USE MAP

DRAWING NO.

1 OF 1

WR1.0