


OWNER:
JACKSON FAMILY
INVESTMENTS III, LLC
421 AVIATION BLVD
SANTA ROSA, CA 95403

CLAIM OF BENEFICIAL USE MAP

T9S, R6W, SECT. 13, TAX LOT 100, W.M.
POLK COUNTY

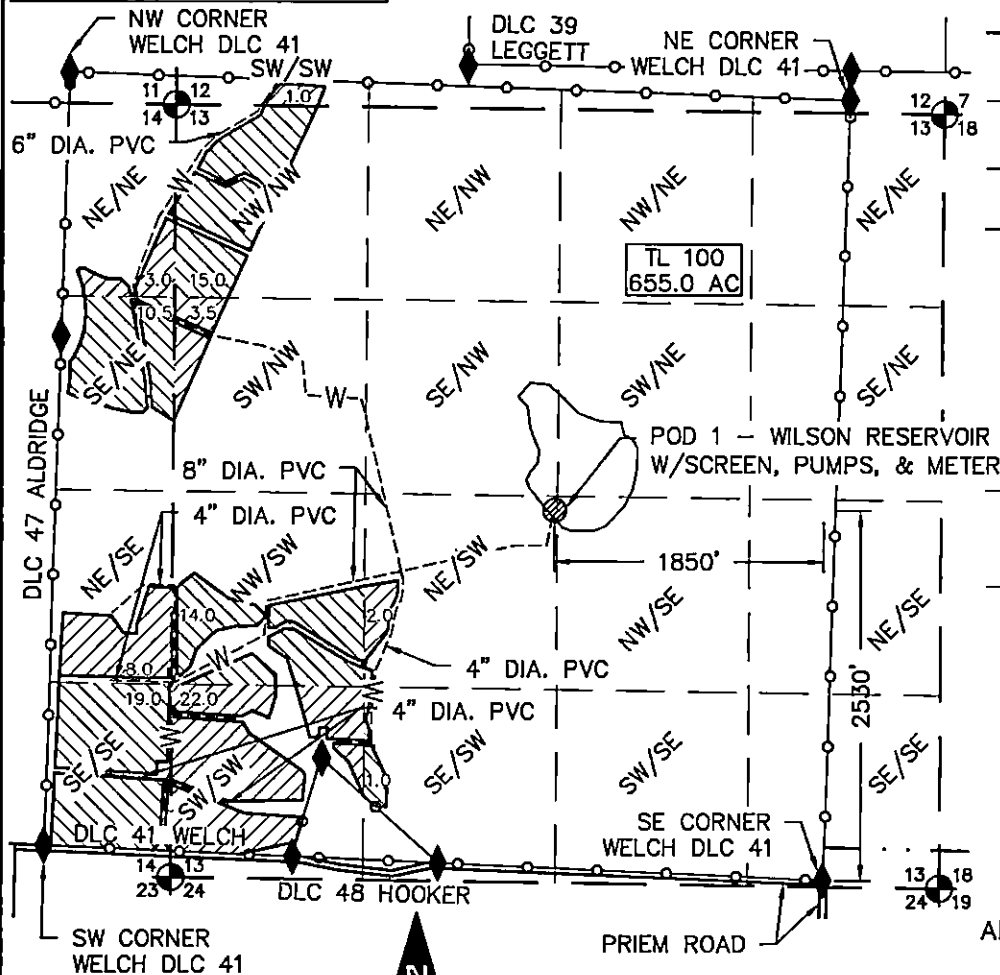

LEGEND

- SECTION LINE
- - - 1/4 1/4 LINE
- - - DLC LINE
- - - TAX LOT LINE
- POD
- ⊕ SECTION CORNER
- ◆ DLC CORNER
- - - 8" DIA. PVC BURIED IRR. MAIN
- - - UNNAMED STREAM

PRIMARY IRRIGATION
APP S-87967
PERMIT S-54912
99.0 ACRES
(PERMITTED 634.3 AC)


PLACE OF USE
APPLICATION S-87967; PERMIT S-54912

TWP	RNG	SEC	Q-Q	TL	DLC	AC
9S	6W	12	SW SW	100	41	1.0
9S	6W	14	NE NE	100	41	3.0
9S	6W	14	SE NE	100	41	10.5
9S	6W	14	NE SE	100	41	8.0
9S	6W	14	SE SE	100	41	19.0
9S	6W	13	NW NW	100	41	15.0
9S	6W	13	SW NW	100	41	3.5
9S	6W	13	NW SW	100	41	14.0
9S	6W	13	NE SW	100	41	2.0
9S	6W	13	SW SW	100	41	22.0
9S	6W	13	SE SW	100	41	1.0
TOTAL ACRES						99.0

Received by OWRD

NOV 20 2025

Salem, OR

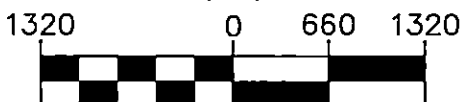

1 inch = 1320ft.

PRINT SCALE=8.5"x11"

AUTHORIZED POINT OF RE-DIVERSION:

POD	TWP	RNG	SEC	Q-Q	TL	DLC	MEASURED DISTANCE
POD 1 - WILSON RESERVOIR	9S	6W	13	NW SE	100	41	2530'N AND 1850'W FROM SE CORNER OF ANDREW WELCH DLC 41

BLUNDON
ENGINEERING, LLC

PO BOX 786
HILLSBORO, OREGON 97123
541-510-5910

NICK@BLUNDONENGINEERING.COM

NOTE: THIS MAP IS PRODUCED TO
APPLY FOR THE BENEFICIAL USE OF A
WATER RIGHT. IT IS NOT INTENDED TO
PROVIDE INFORMATION RELATIVE TO
THE LOCATION OF PROPERTY LINES.

Certified Water Right Examiner
#83725
Nicholas D. Blundon
NICHOLAS GORDON BLUNDON
MAY 14, 2019
STATE OF OREGON
EXPIRES 12/31/2027