


# CLAIM OF BENEFICIAL USE MAP

TO CHANGE PLACE OF USE AND  
ADD A POINT OF APPROPRIATION  
PER T-13162  
FOR GOLDEN RULE FARMS, INC.

TOWNSHIP 27 SOUTH, RANGE 17 EAST, SECTION 19, W.M.  
TAX LOT: 1600

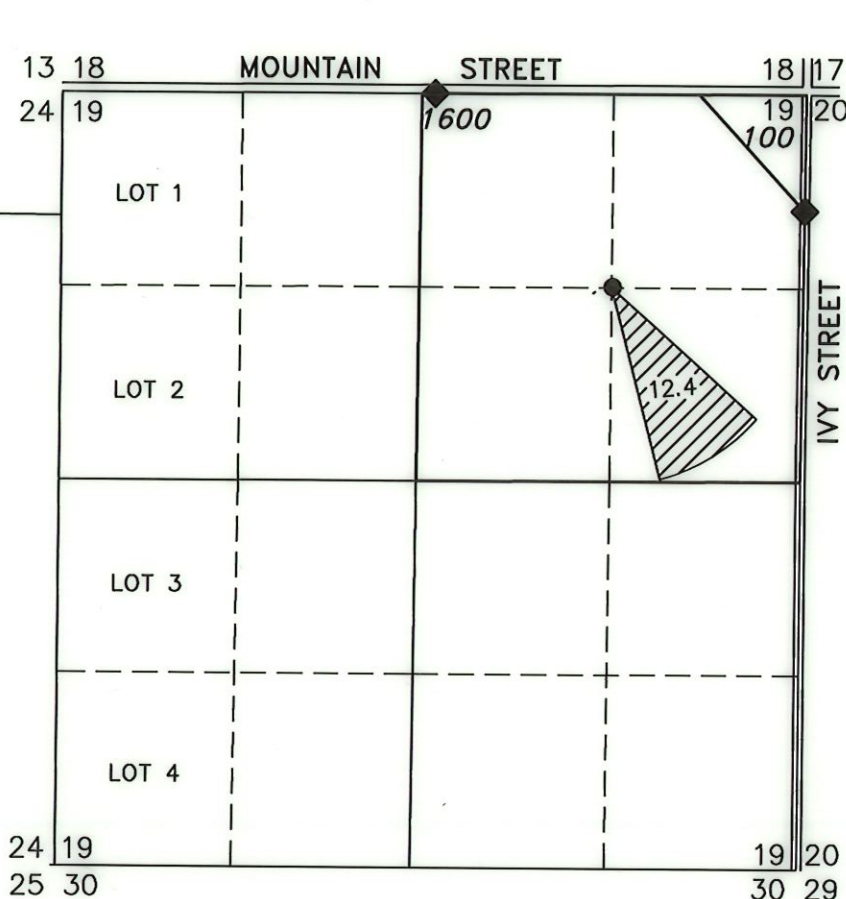

SCALE: 4 INCHES = 1 MILE

Received  
NOV 25 2025  
OWRD



12.4 ACRES 'IR' FROM C/52365  
(G-9174), AS SHOWN.



SURVEY MONUMENT FOUND  
AND TIED PER CS 6347



RENEWAL DATE: 12/31/2026

## ● LAKE 1027

EXISTING WELL IN THE SW 1/4 NE 1/4 SECTION 19, T27S  
R17E, W.M. LOCATED 1322 FEET SOUTH AND 1335 FEET  
WEST FROM THE NORTHEAST CORNER OF SECTION 19.

NEWLY INSTALLED METER IS APPROXIMATELY 4.0 FEET  
EAST ALONG DELIVERY PIPE FROM CENTER PIVOT.

THIS MAP IS FOR THE PURPOSE OF LOCATING A WATER  
RIGHT ONLY AND HAS NO INTENT TO PROVIDE LEGAL  
DIMENSIONS OR THE LOCATION OF PROPERTY LINES

## PREPARED FOR:

GOLDEN RULE FARMS, INC.  
P.O. BOX 255  
CHRISTMAS VALLEY, OR 97641

## PREPARED BY:




ALL POINTS ENGINEERING AND SURVEYING, INC.  
P.O. BOX 767 (CRR) TERREBONNE, OR 97760  
(541) 548-5833  
www.APEandS.com

# CLAIM OF BENEFICIAL USE MAP

TO CHANGE PLACE OF USE AND  
ADD A POINT OF APPROPRIATION  
PER T-13162  
FOR GOLDEN RULE FARMS, INC.

TOWNSHIP 27 SOUTH, RANGE 17 EAST, SECTION 19, W.M.  
TAX LOT: 1600

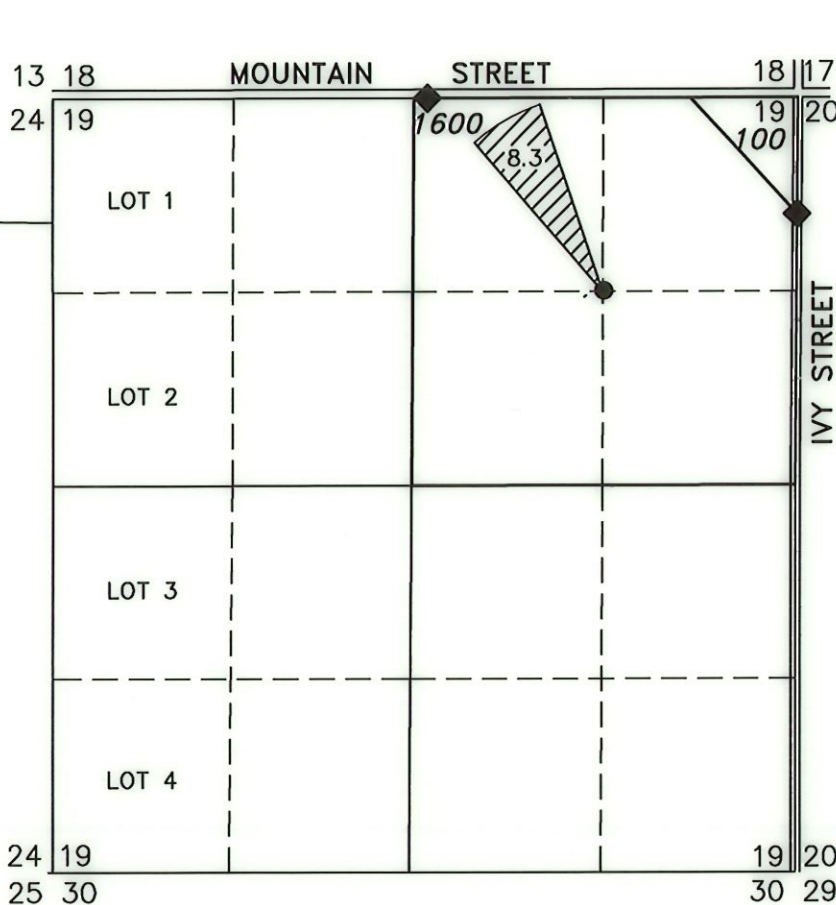

Received  
NOV 25 2025  
OWRD



8.3 ACRES 'IR' FROM C#86437  
(U-487), AS SHOWN.



SURVEY MONUMENT FOUND  
AND TIED PER CS 6347



RENEWAL DATE: 12/31/2026

## LAKE 1027

EXISTING WELL IN THE SW 1/4 NE 1/4 SECTION 19, T27S  
R17E, W.M. LOCATED 1322 FEET SOUTH AND 1335 FEET  
WEST FROM THE NORTHEAST CORNER OF SECTION 19.

NEWLY INSTALLED METER IS APPROXIMATELY 4.0 FEET  
EAST ALONG DELIVERY PIPE FROM CENTER PIVOT.

THIS MAP IS FOR THE PURPOSE OF LOCATING A WATER  
RIGHT ONLY AND HAS NO INTENT TO PROVIDE LEGAL  
DIMENSIONS OR THE LOCATION OF PROPERTY LINES

## PREPARED FOR:

GOLDEN RULE FARMS, INC.  
P.O. BOX 255  
CHRISTMAS VALLEY, OR 97641

## PREPARED BY:




ALL POINTS ENGINEERING AND SURVEYING, INC.  
P.O. BOX 767 (CRR) TERREBONNE, OR 97760  
(541) 548-5833  
www.APEandS.com



# CLAIM OF BENEFICIAL USE MAP

TO CHANGE PLACE OF USE AND  
ADD A POINT OF APPROPRIATION  
PER T-13162  
FOR GOLDEN RULE FARMS, INC.

TOWNSHIP 27 SOUTH, RANGE 17 EAST, SECTION 19, W.M.  
TAX LOT: 1600

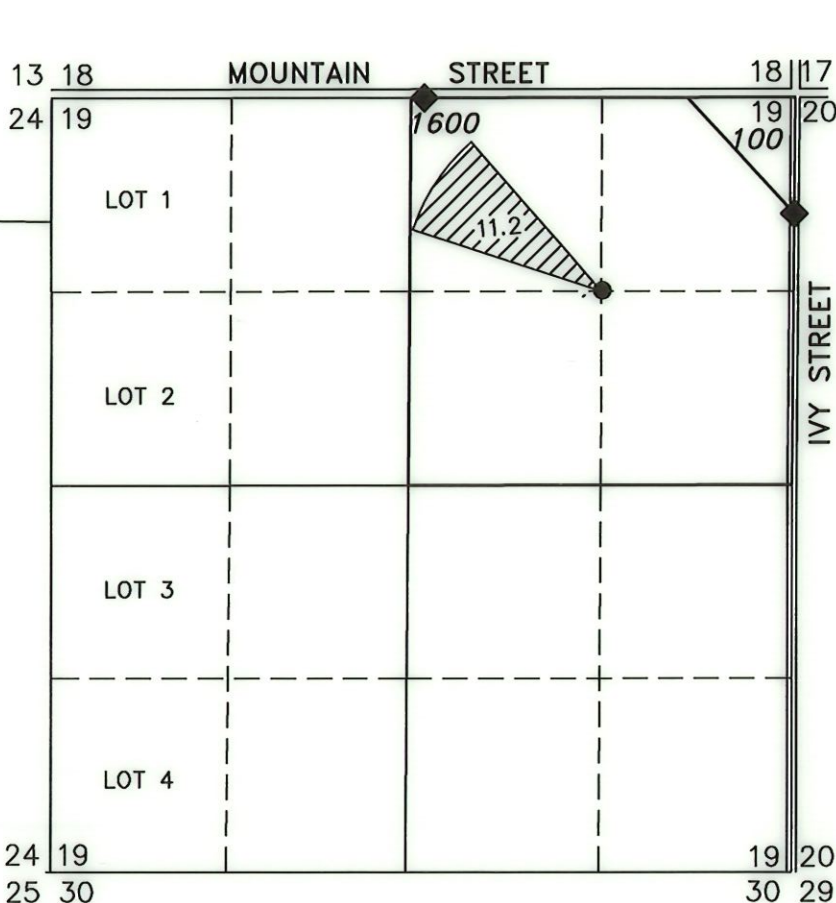

SCALE: 4 INCHES = 1 MILE


Received  
NOV 25 2025  
OWRD



11.2 ACRES 'IR' FROM C#68387  
(U-487), AS SHOWN.



SURVEY MONUMENT FOUND  
AND TIED PER CS 6347

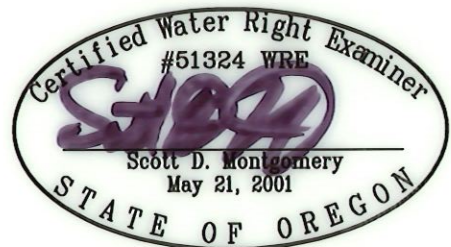

RENEWAL DATE: 12/31/2026

## ● LAKE 1027

EXISTING WELL IN THE SW 1/4 NE 1/4 SECTION 19, T27S  
R17E, W.M. LOCATED 1322 FEET SOUTH AND 1335 FEET  
WEST FROM THE NORTHEAST CORNER OF SECTION 19.

NEWLY INSTALLED METER IS APPROXIMATELY 4.0 FEET  
EAST ALONG DELIVERY PIPE FROM CENTER PIVOT.

THIS MAP IS FOR THE PURPOSE OF LOCATING A WATER  
RIGHT ONLY AND HAS NO INTENT TO PROVIDE LEGAL  
DIMENSIONS OR THE LOCATION OF PROPERTY LINES

## PREPARED FOR:

GOLDEN RULE FARMS, INC.  
P.O. BOX 255  
CHRISTMAS VALLEY, OR 97641

## PREPARED BY:




ALL POINTS ENGINEERING AND SURVEYING, INC.  
P.O. BOX 767 (CRR) TERREBONNE, OR 97760  
(541) 548-5833  
www.APEandS.com

# CLAIM OF BENEFICIAL USE MAP

TO CHANGE PLACE OF USE AND  
ADD A POINT OF APPROPRIATION  
PER T-13162  
FOR GOLDEN RULE FARMS, INC.

TOWNSHIP 27 SOUTH, RANGE 17 EAST, SECTION 19, W.M.  
TAX LOT: 1600

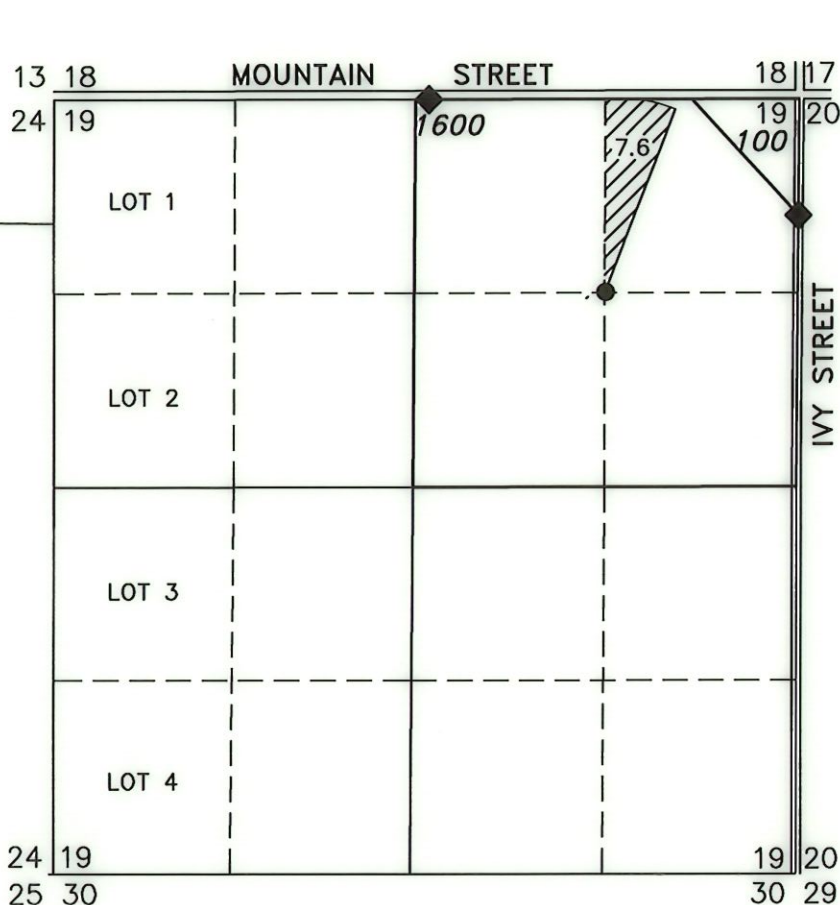


Received  
NOV 25 2025  
OWRD



7.6 ACRES 'IR' FROM C#82617  
(G-10224), AS SHOWN.



SURVEY MONUMENT FOUND  
AND TIED PER CS 6347

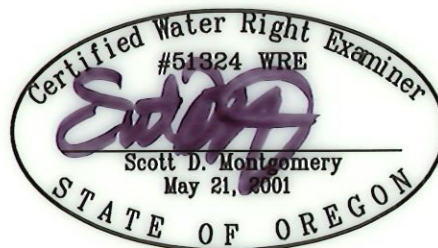

RENEWAL DATE: 12/31/2026

## ● LAKE 1027

EXISTING WELL IN THE SW 1/4 NE 1/4 SECTION 19, T27S  
R17E, W.M. LOCATED 1322 FEET SOUTH AND 1335 FEET  
WEST FROM THE NORTHEAST CORNER OF SECTION 19.

NEWLY INSTALLED METER IS APPROXIMATELY 4.0 FEET  
EAST ALONG DELIVERY PIPE FROM CENTER PIVOT.

THIS MAP IS FOR THE PURPOSE OF LOCATING A WATER  
RIGHT ONLY AND HAS NO INTENT TO PROVIDE LEGAL  
DIMENSIONS OR THE LOCATION OF PROPERTY LINES

## PREPARED FOR:

GOLDEN RULE FARMS, INC.  
P.O. BOX 255  
CHRISTMAS VALLEY, OR 97641

## PREPARED BY:




ALL POINTS ENGINEERING AND SURVEYING, INC.  
P.O. BOX 767 (CRR) TERREBONNE, OR 97760  
(541) 548-5833  
www.APEandS.com



# CLAIM OF BENEFICIAL USE MAP

TO CHANGE PLACE OF USE AND  
ADD A POINT OF APPROPRIATION  
PER T-13162  
FOR GOLDEN RULE FARMS, INC.

TOWNSHIP 27 SOUTH, RANGE 17 EAST, SECTION 19, W.M.  
TAX LOT: 1600

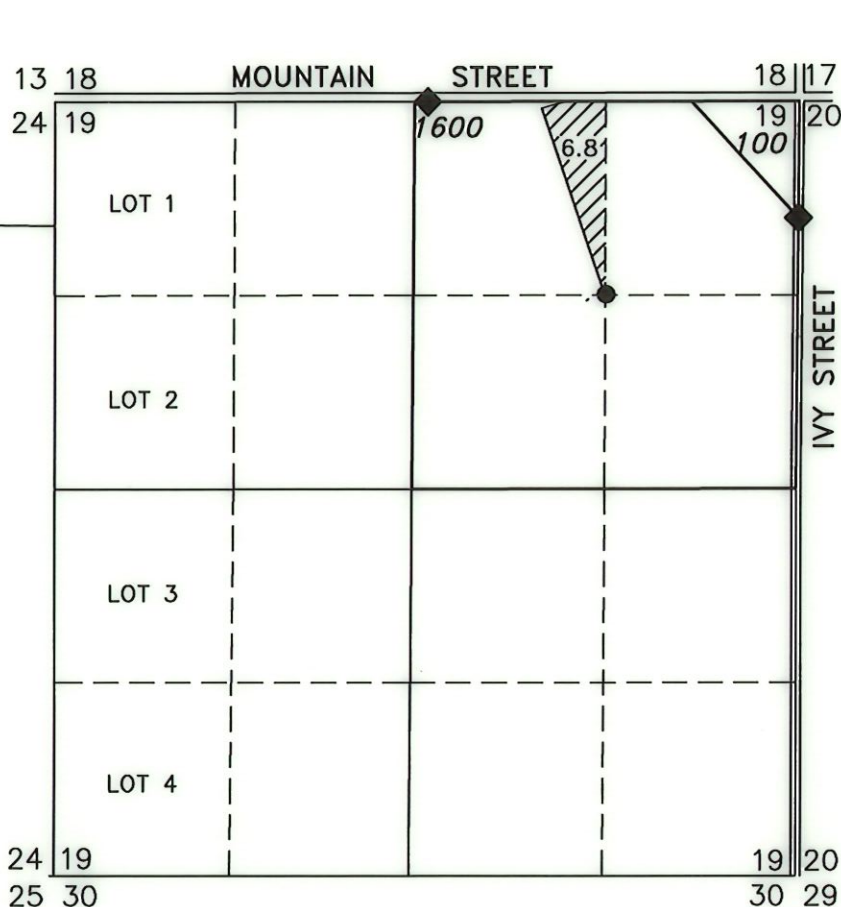

Received  
NOV 25 2025  
OWRD



6.8 ACRES 'IR' FROM C#82618  
(U-487), AS SHOWN.



SURVEY MONUMENT FOUND  
AND TIED PER CS 6347



RENEWAL DATE: 12/31/2026

## ● LAKE 1027

EXISTING WELL IN THE SW 1/4 NE 1/4 SECTION 19, T27S  
R17E, W.M. LOCATED 1322 FEET SOUTH AND 1335 FEET  
WEST FROM THE NORTHEAST CORNER OF SECTION 19.

NEWLY INSTALLED METER IS APPROXIMATELY 4.0 FEET  
EAST ALONG DELIVERY PIPE FROM CENTER PIVOT.

THIS MAP IS FOR THE PURPOSE OF LOCATING A WATER  
RIGHT ONLY AND HAS NO INTENT TO PROVIDE LEGAL  
DIMENSIONS OR THE LOCATION OF PROPERTY LINES

## PREPARED FOR:

GOLDEN RULE FARMS, INC.  
P.O. BOX 255  
CHRISTMAS VALLEY, OR 97641

## PREPARED BY:




ALL POINTS ENGINEERING AND SURVEYING, INC.  
P.O. BOX 767 (CRR) TERREBONNE, OR 97760  
(541) 548-5833  
www.APEandS.com

# CLAIM OF BENEFICIAL USE MAP

TO CHANGE PLACE OF USE AND  
ADD A POINT OF APPROPRIATION  
PER T-13162  
FOR GOLDEN RULE FARMS, INC.

TOWNSHIP 27 SOUTH, RANGE 17 EAST, SECTION 19, W.M.  
TAX LOT: 1600

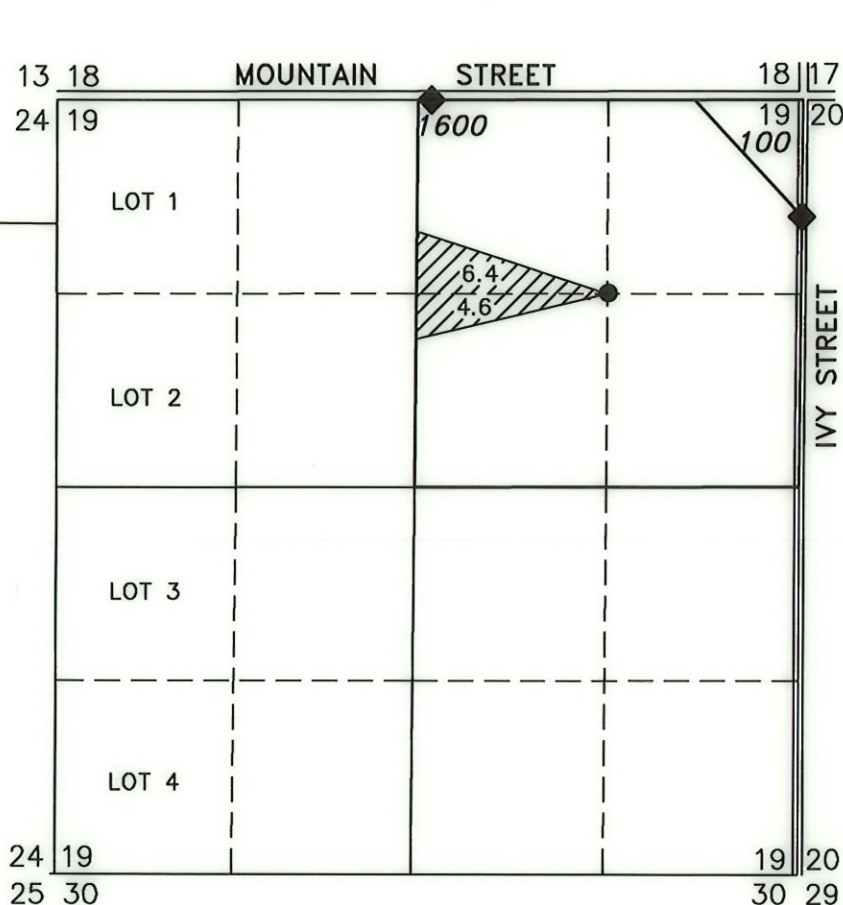


Received  
NOV 25 2025  
OWRD



11.0 ACRES 'IR' FROM C#82619  
(G-2165), AS SHOWN.



SURVEY MONUMENT FOUND  
AND TIED PER CS 6347

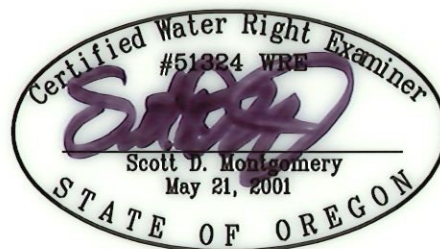

RENEWAL DATE: 12/31/2026

## ● LAKE 1027

EXISTING WELL IN THE SW 1/4 NE 1/4 SECTION 19, T27S  
R17E, W.M. LOCATED 1322 FEET SOUTH AND 1335 FEET  
WEST FROM THE NORTHEAST CORNER OF SECTION 19.

NEWLY INSTALLED METER IS APPROXIMATELY 4.0 FEET  
EAST ALONG DELIVERY PIPE FROM CENTER PIVOT.

THIS MAP IS FOR THE PURPOSE OF LOCATING A WATER  
RIGHT ONLY AND HAS NO INTENT TO PROVIDE LEGAL  
DIMENSIONS OR THE LOCATION OF PROPERTY LINES

## PREPARED FOR:

GOLDEN RULE FARMS, INC.  
P.O. BOX 255  
CHRISTMAS VALLEY, OR 97641

## PREPARED BY:



ALL POINTS ENGINEERING AND SURVEYING, INC.  
P.O. BOX 767 (CRR) TERREBONNE, OR 97760  
(541) 548-5833  
www.APEandS.com




# CLAIM OF BENEFICIAL USE MAP

TO CHANGE PLACE OF USE AND  
ADD A POINT OF APPROPRIATION  
PER T-13162  
FOR GOLDEN RULE FARMS, INC.

TOWNSHIP 27 SOUTH, RANGE 17 EAST, SECTION 19, W.M.  
TAX LOT: 1600


Received  
NOV 25 2025

OWRD

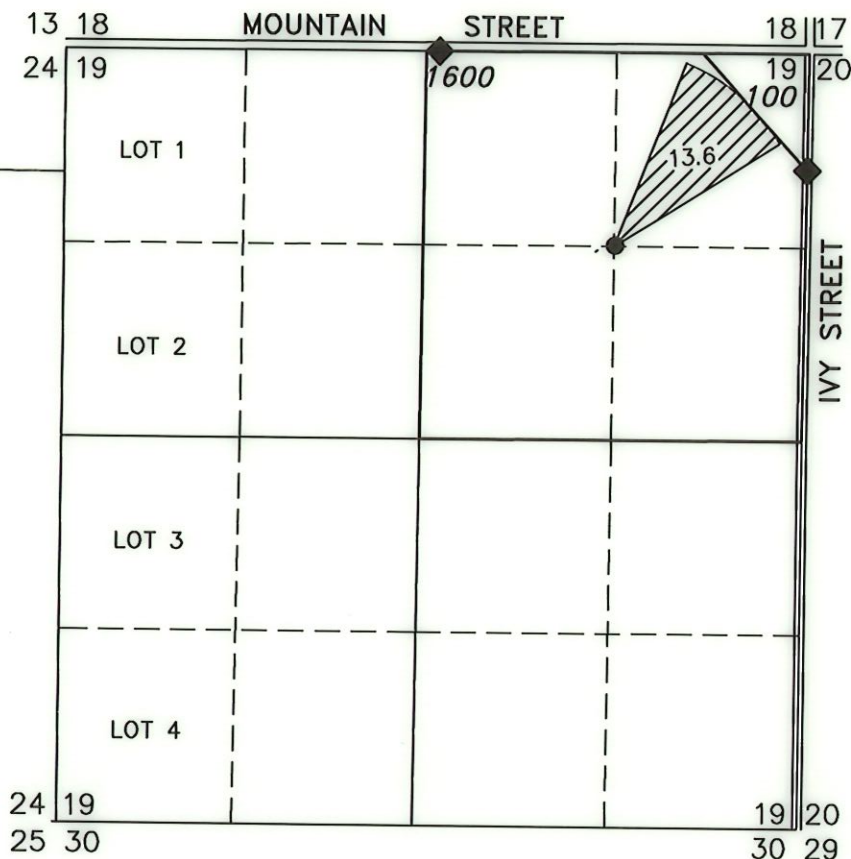

13.6 ACRES 'IR' FROM C#53235  
(G-10297), AS SHOWN.

◆ SURVEY MONUMENT FOUND  
AND TIED PER CS 6347

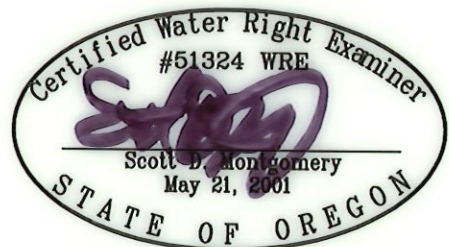

RENEWAL DATE: 12/31/2026

## ● LAKE 1027

EXISTING WELL IN THE SW 1/4 NE 1/4 SECTION 19, T27S  
R17E, W.M. LOCATED 1322 FEET SOUTH AND 1335 FEET  
WEST FROM THE NORTHEAST CORNER OF SECTION 19.

NEWLY INSTALLED METER IS APPROXIMATELY 4.0 FEET  
EAST ALONG DELIVERY PIPE FROM CENTER PIVOT.

THIS MAP IS FOR THE PURPOSE OF LOCATING A WATER  
RIGHT ONLY AND HAS NO INTENT TO PROVIDE LEGAL  
DIMENSIONS OR THE LOCATION OF PROPERTY LINES

## PREPARED FOR:

GOLDEN RULE FARMS, INC.  
P.O. BOX 255  
CHRISTMAS VALLEY, OR 97641

## PREPARED BY:




ALL POINTS ENGINEERING AND SURVEYING, INC.  
P.O. BOX 767 (CRR) TERREBONNE, OR 97760  
(541) 548-5833  
www.APEandS.com

# CLAIM OF BENEFICIAL USE MAP

TO CHANGE PLACE OF USE AND  
ADD A POINT OF APPROPRIATION  
PER T-13162  
FOR GOLDEN RULE FARMS, INC.


TOWNSHIP 27 SOUTH, RANGE 17 EAST, SECTION 26, W.M.  
TAX LOT: 2800

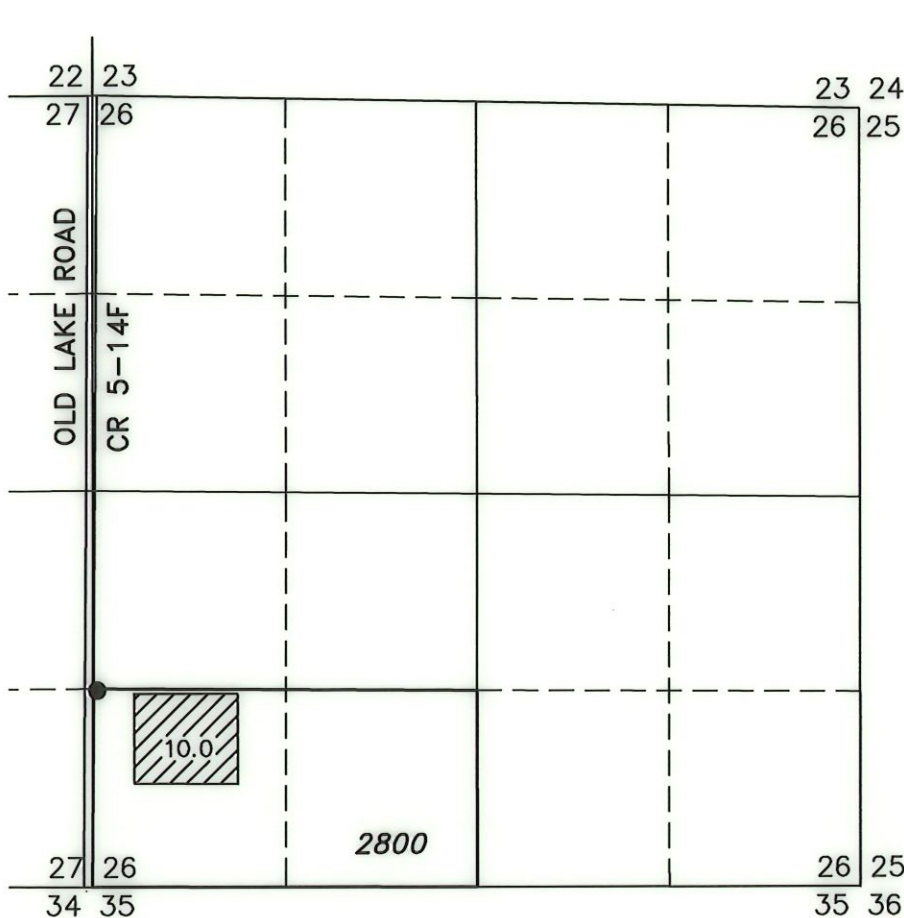

Received  
NOV 25 2025  
OWRD



10.0 ACRES 'IR' FROM C#82617  
(G-10224), AS SHOWN.

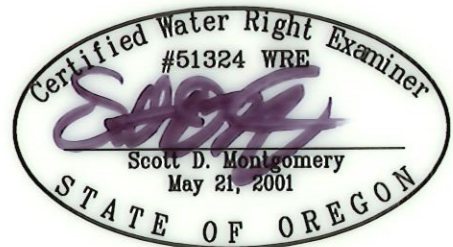

RENEWAL DATE: 12/31/2026

● LAKE 1062

EXISTING WELL IN THE SW 1/4 SW 1/4 SECTION 26,  
T27S R17E, W.M. LOCATED 1366 FEET SOUTH AND 32.8  
FEET EAST FROM THE W 1/4 CORNER OF SECTION 26.

NEWLY INSTALLED METER IS APPROXIMATELY 6 FEET  
SOUTH ALONG DELIVERY PIPE FROM WELL.

THIS MAP IS FOR THE PURPOSE OF LOCATING A WATER  
RIGHT ONLY AND HAS NO INTENT TO PROVIDE LEGAL  
DIMENSIONS OR THE LOCATION OF PROPERTY LINES

PREPARED FOR:

GOLDEN RULE FARMS, INC.  
P.O. BOX 255  
CHRISTMAS VALLEY, OR 97641

PREPARED BY:



ALL POINTS ENGINEERING AND SURVEYING, INC.  
P.O. BOX 767 (CRR) TERREBONNE, OR 97760  
(541) 548-5833  
www.APEandS.com




# CLAIM OF BENEFICIAL USE MAP

TO CHANGE PLACE OF USE AND  
ADD A POINT OF APPROPRIATION  
PER T-13162  
FOR GOLDEN RULE FARMS, INC.

TOWNSHIP 27 SOUTH, RANGE 17 EAST, SECTION 19, W.M.  
TAX LOT: 1600

Received  
NOV 25 2025


OWRD

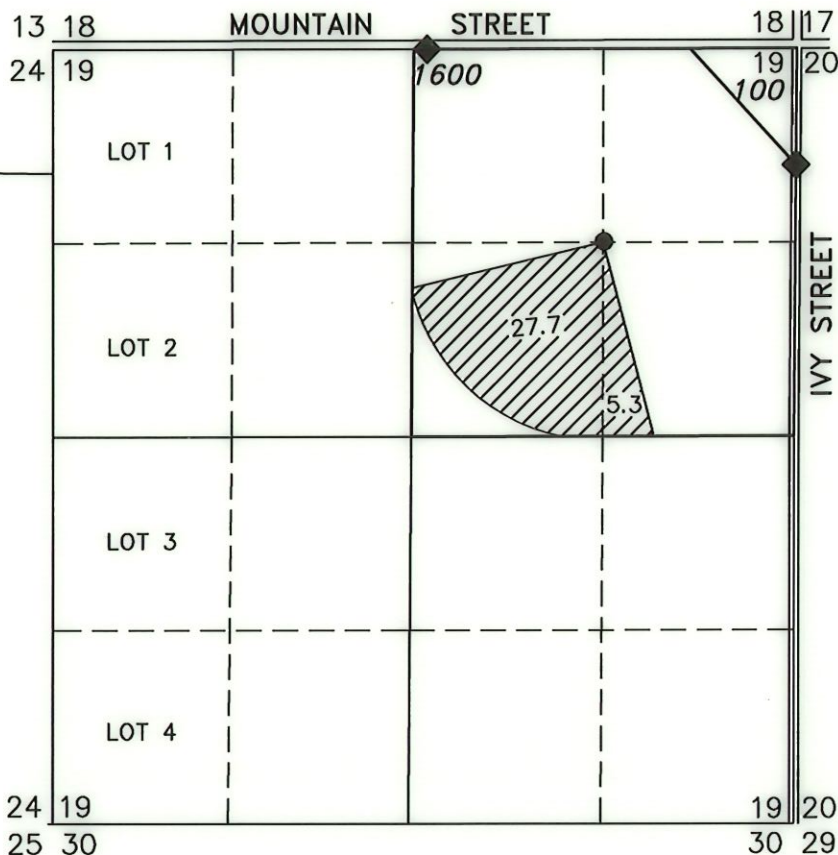

33.0 ACRES 'ir' FROM  
C#81515 (G-7011), AS SHOWN.



SURVEY MONUMENT FOUND  
AND TIED PER CS 6347

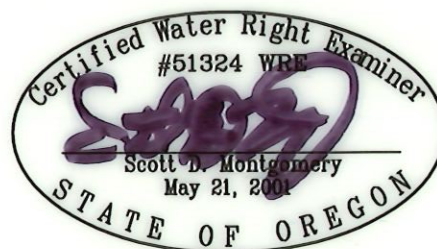

RENEWAL DATE: 12/31/2026

## LAKE 1027

EXISTING WELL IN THE SW 1/4 NE 1/4 SECTION 19, T27S  
R17E, W.M. LOCATED 1322 FEET SOUTH AND 1335 FEET  
WEST FROM THE NORTHEAST CORNER OF SECTION 19.

NEWLY INSTALLED METER IS APPROXIMATELY 4.0 FEET  
EAST ALONG DELIVERY PIPE FROM CENTER PIVOT.

THIS MAP IS FOR THE PURPOSE OF LOCATING A WATER  
RIGHT ONLY AND HAS NO INTENT TO PROVIDE LEGAL  
DIMENSIONS OR THE LOCATION OF PROPERTY LINES

## PREPARED FOR:

GOLDEN RULE FARMS, INC.  
P.O. BOX 255  
CHRISTMAS VALLEY, OR 97641

## PREPARED BY:



ALL POINTS ENGINEERING AND SURVEYING, INC.  
P.O. BOX 767 (CRR) TERREBONNE, OR 97760  
(541) 548-5833  
www.APEandS.com